

THOMAS SUDRON & Co., Limited

IMPERIAL BOILER WORKS,

STOCKTON-ON-TEES

SKETCH OF IRON LOWERMASTS.

Scale $\frac{1}{4}$ = 1 Foot

204



TOP MESS^{RS} FURNESS, WITBY & CO^S NO ~~204~~ S S

Particulars in Red
for No 205 S/S

4/12/93.
4/12/93.

Note: Butts in housing ~~at~~ double riveted, remainder
treble riveted, with straps 16 thicker than the plates they connect
Seams Single riveted.

No 204 S/S { All butt straps to be $\frac{1}{2}$ thicker than plates they connect
Rivets in Butts to be spaced 5 diameters apart.

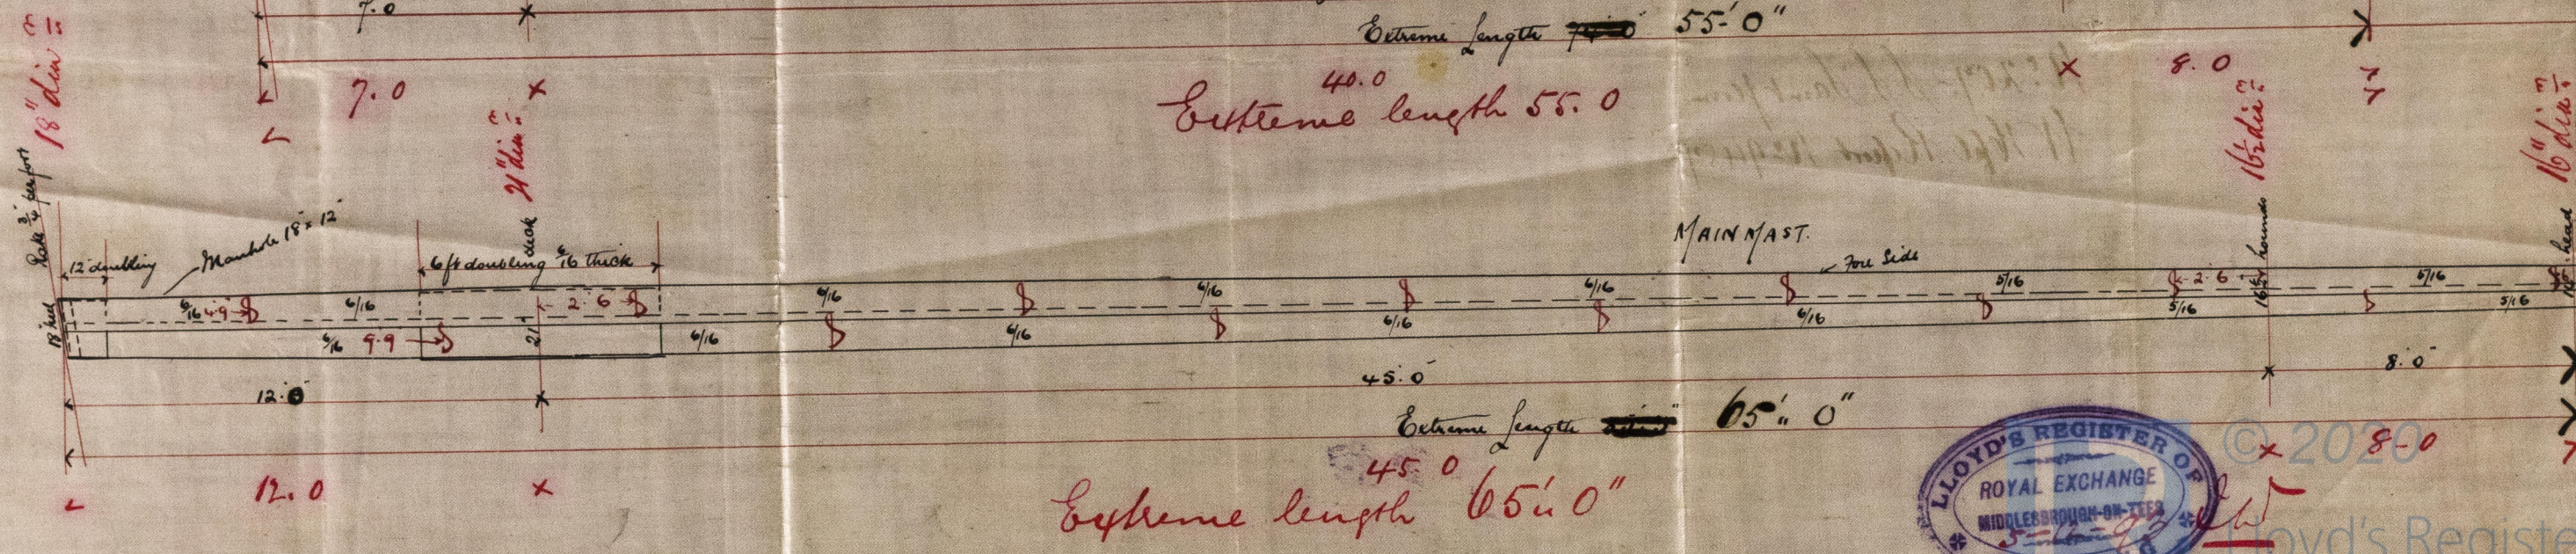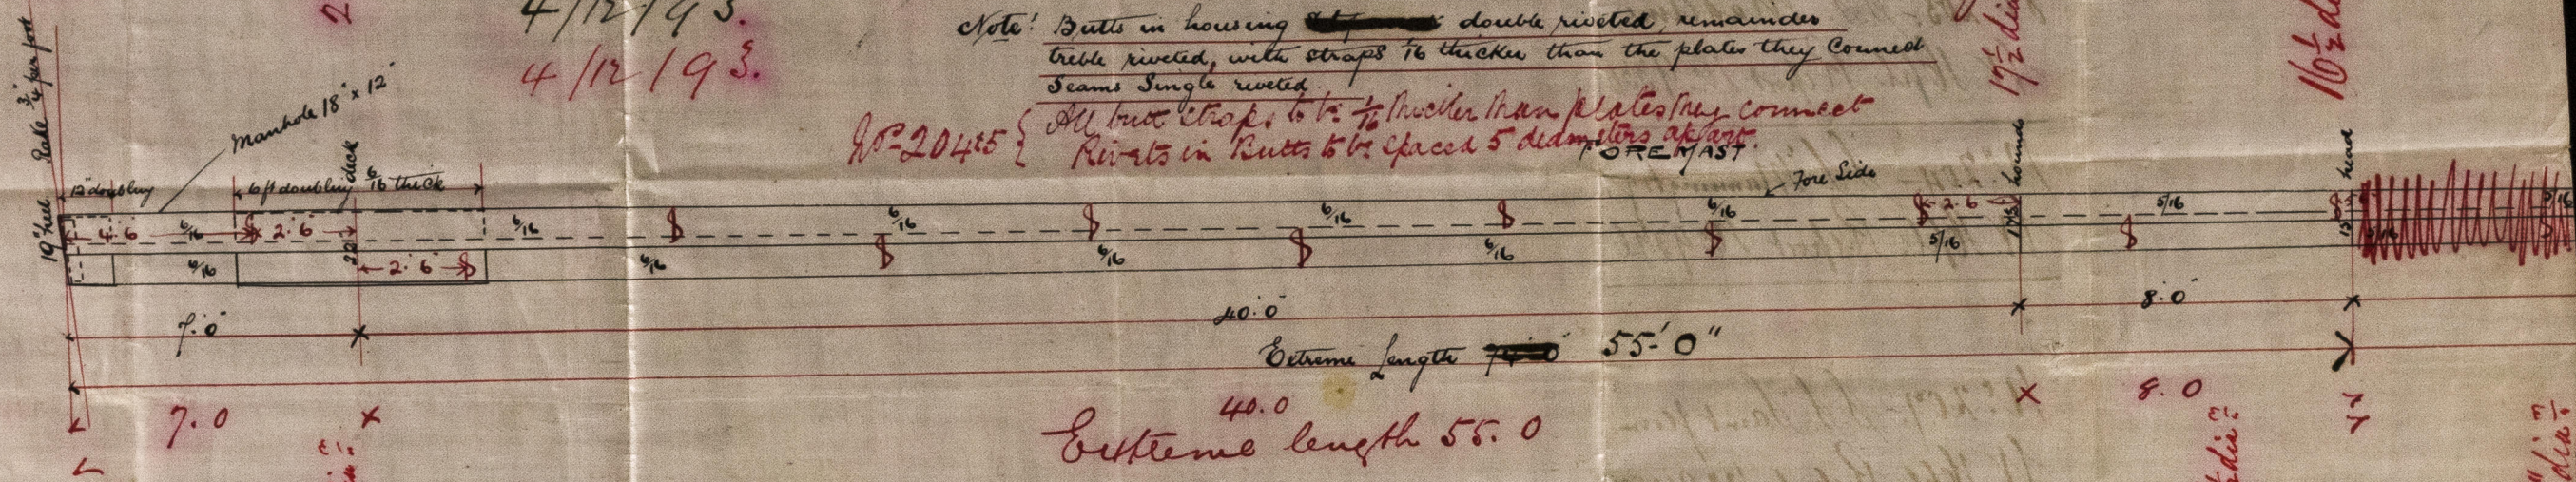

© 2020
Lloyd's Register
Foundation

Horness Worthy & Co.

No. 204 45

Iron masts

No. 205. J. S. Madeline;
W. Hpl. Report No. 9336

No. 204. J. S. Manningtry;
W. Hpl. Report No. 9396

No. 207. J. S. Saint Jerome;
W. Hpl. Report No. 9487

HPL372-0121



2020

Lloyd's Register
Foundation