

S. S. Manning

WEST HARTLEPOOL.

Received at

Office.

2nd Ferry 1894.

Lloyd's Register of British and Foreign Shipping.

(Report on Vessel No. 9376 Port WEST HARTLEPOOL.)

Wpool

No. 2636.a

SHIP FORGINGS OR CASTINGS.

The words FORGINGS OF CASTINGS, IRON OR STEEL, should be struck out as may be required.

I have to report that the undermentioned Iron or ~~Steel~~ Forgings or Castings, manufactured by *Mp^r & Co.* of *Wartlepool* for the Vessel No. *2044*, being built by *Mp^r Furness Withy & Co.* of *Wartlepool* have been inspected by me as set forth below, and found to be, so far as can be seen, *sound*

Mark on Forgings.

Lloyd's

No. *2636a*
W.C.


Wugh Cameron

Superintendent

30-12-93

	STERN FRAME.	RUDDER FRAME.	STEM.
Material*	<i>Scrap iron</i>	<i>Scrap iron</i>	<i>Scrap iron</i>
How made	<i>Forged</i>	<i>Forged</i>	<i>Forged</i>
Dimensions	<i>10" x 6'</i>	<i>8" - 4'</i>	<i>10" x 2 3/4</i>
Progress on Inspection	<i>Forged & milled</i>	<i>Forged & milled</i>	<i>Forged</i>
Date when Inspected	<i>Oct 5th to 24/93</i>	<i>Nov 3rd to Dec 7/93</i>	<i>Oct 14/93</i>

SKETCHES OF FRAMES SHOWING POSITION AND DESCRIPTION OF WELDS OF FORGINGS, OR PARTICULARS OF TESTS APPLIED TO CASTINGS.

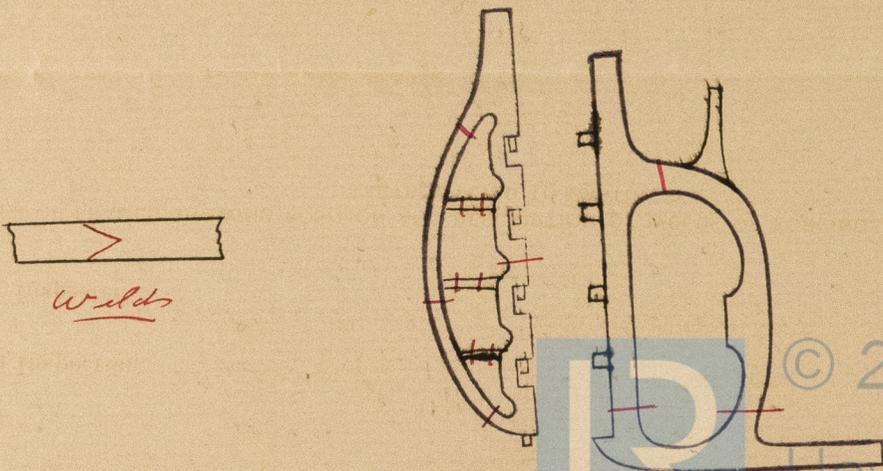

* If of Iron, state whether scrap or puddled Iron.