

Lloyd's Register of British and Foreign Shipping.

(Report on Vessel No. 9401 Port WEST HARTLEPOOL.)No. 1638 a

SHIP FORGINGS OR CASTINGS.

I have to report that the undermentioned Iron or Steel Forgings or Castings, manufactured by Messrs L Richardson & Sons of Hartlepool for the Vessel No. 206, being built by Messrs Furness Withy & Co. of Hartlepool have been inspected by me as set forth below, and found to be, so far as can be seen, sound


Mark on Forgings.

Lloyd's

No. 2638 a10.6.Wm Hugh CameronSunderland
30.12.93

	STERN FRAME.	RUDDER FRAME.	STEM.
Material*	<u>scrap iron</u>	<u>Scrap iron</u>	<u>scrap iron</u>
How made	<u>Forged</u>	<u>Forged</u>	<u>Forged</u>
Dimensions	<u>10" x 6"</u>	<u>8" x 4"</u>	<u>10" x 2 3/4"</u>
Progress on Inspection	<u>Forged & milled</u>	<u>Forged & milled</u>	<u>Forged</u>
Date when Inspected	<u>Oct 5th to 24/93</u>	<u>Nov 3rd to Dec 22/93</u>	<u>Oct 24/93</u>

SKETCHES OF FRAMES SHOWING POSITION AND DESCRIPTION OF WELDS OF FORGINGS, OR PARTICULARS OF TESTS APPLIED TO CASTINGS.

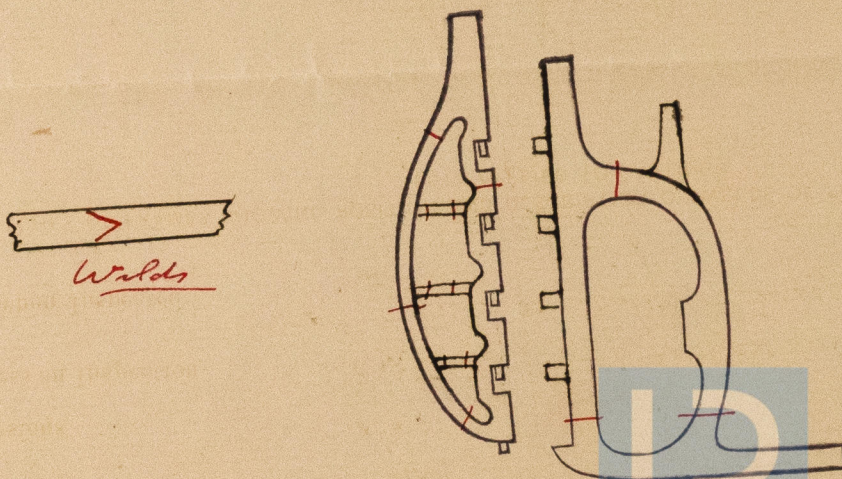

* If of Iron, state whether scrap or puddled Iron.