


PUMPING ARRANGEMENT

Ref: 28.5.94

Ref: 25.5.94

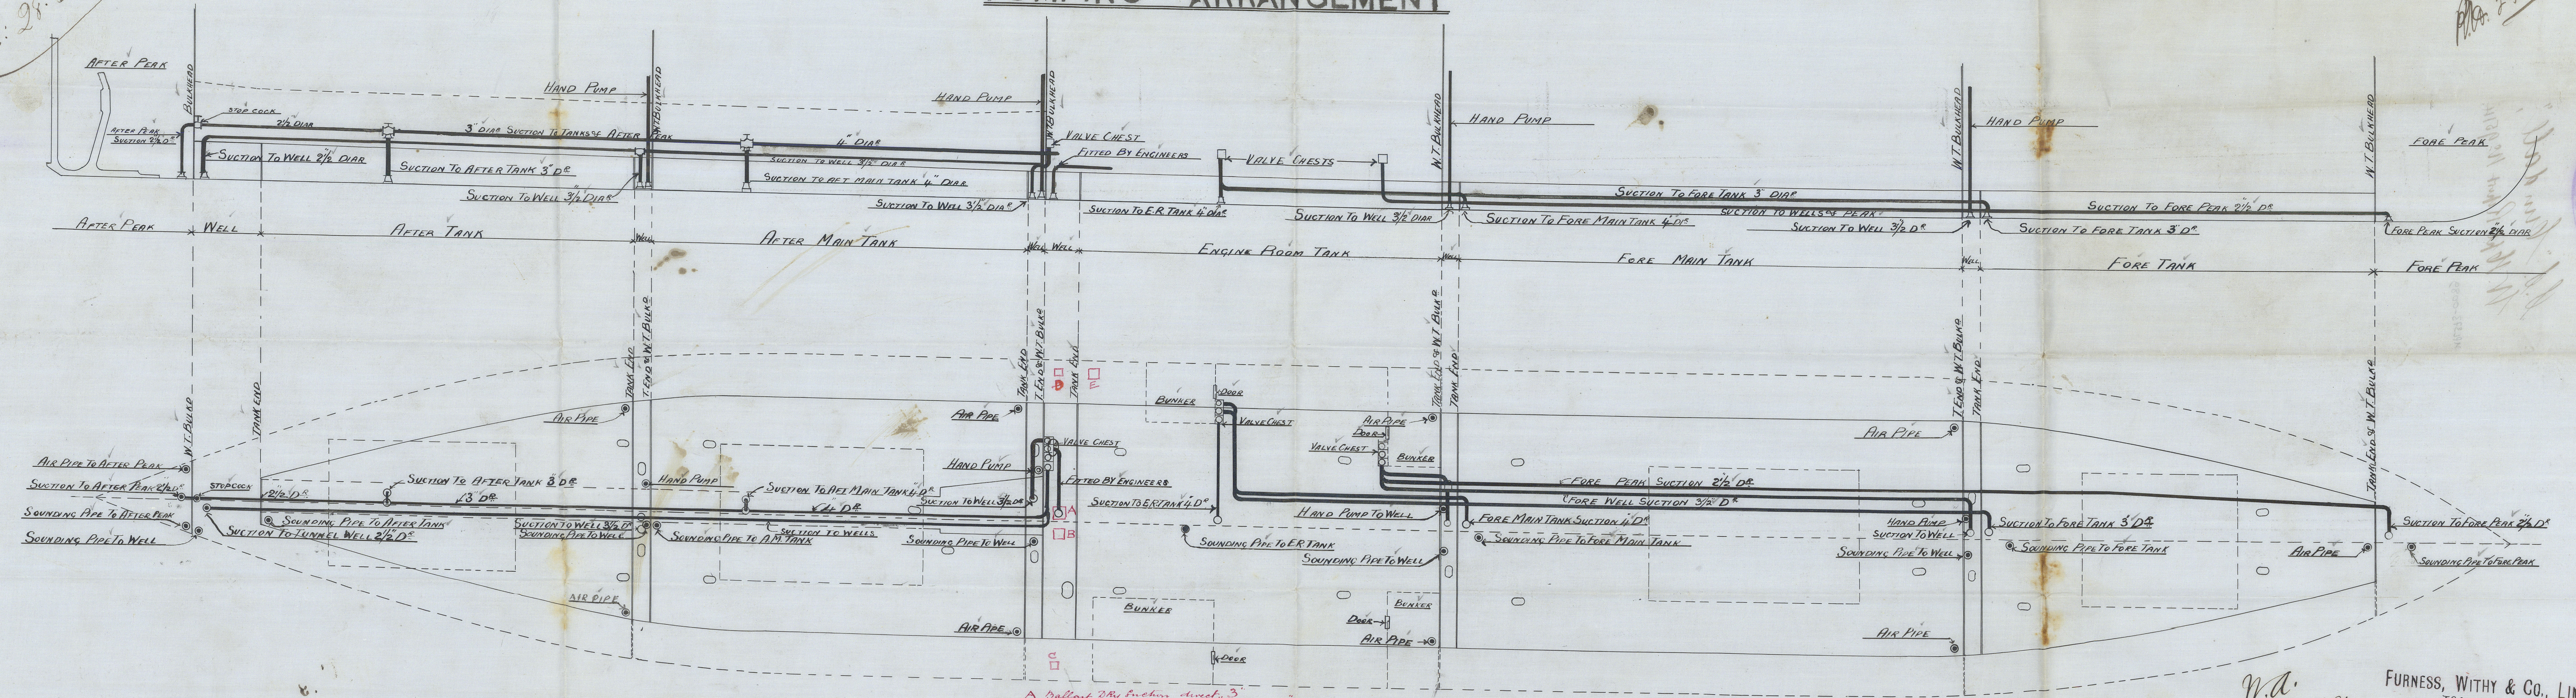


A Ballast Bay suction direct 3" main engine feed double 2 3/4" bilge injection 6"

NO 208 under deck tonnage about 1800 tons.

N.A. 26.5.94


FURNESS, WITHEY & CO., LIMITED.
TRACING NO 12055
SHIPBUILDERS & REPAIRERS
MAY 12/1944
WEST HARTLEPOOL

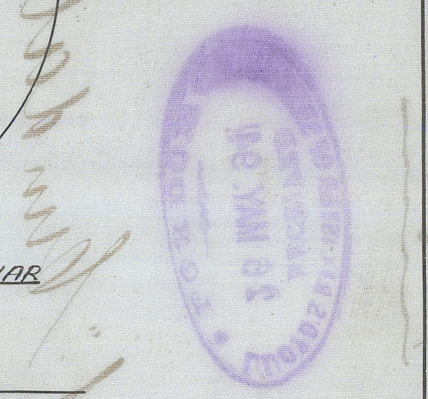

Furness Withy & Co.

No. 208.

Pumping plan.

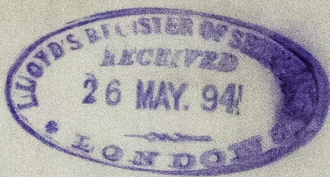

S. J. "Cundall",
W. H. R. Report No. 9514.

HPL373-0089

R

© 2021

Lloyd's Register
Foundation