

4.8.92  
6.10.92  
21.10.92

197<sup>1/2</sup>  
16.11.92  
13.4.93  
198  
10.12.92  
13.4.93

202<sup>1/2</sup> (now 203)  
20.2.93 1/7/93

Nos. ~~204~~, 205 and 206  
14.9.93

No ~~207~~  
2.10.93

# MIDSHIP SECTION

SCALE  $\frac{1}{2}$ " = 1 FOOT.



Middle line  
bulkhead  
1/4" steel  
rings spaced 5'-14" apart  
INCREASED  $\frac{1}{20}$  FOR  $\frac{1}{2}$  LENGTH  
IN WAY OF BREAK  
Beam knees 3/4" thicker  
or bulk curved inside  
N 42" x 13-10  
INCREASED  $\frac{2}{20}$  FOR  $\frac{3}{4}$  LENGTH

Middle line  
bulkhead  
5/16" iron  
stiffeners 5' x 3" x 16" (double)  
4' ft. apart.

LLOYDS NUMERALS	
HALF BEAM MOULDED	20'2"
DEPTH OF HOLD & FLOORS	24'8"
HALF GIRTH	40'0"
FRAME NUMBER	84'10"
LENGTH PER RULE	312'4"
PLATING NUMBER	76495
EQUIPMENT NUMBER	29807
BEAMS IN LENGTH	7.74
DEPTHS IN LENGTH	12.67
CLASS 100 A.I. PARTIAL AWNING DECK	
ALL SCANTLINGS OF STEEL	
EXCEPT WHERE OTHERWISE SPECIFIED	


N<sup>o</sup> 196

FLOORS FLANGED TOP & BOTTOM 9" THICK  
TANK INTERCOSTAL FLANGED TOP & BOTTOM 9" THICK  
BRACKETS FLANGED AT TOP 8" THICK

FURNESS, WITBY & CO., LIMITED.  
SHIPBUILDERS & SHIPOWNERS  
WEST HARTLEPOOL  
21st July 1892



Machine Section

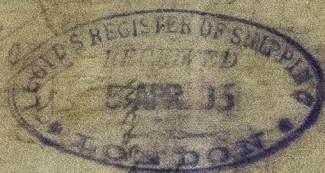

HPL 373-0095

S. S. Gumpress <sup>now</sup> <sup>Cadiz</sup>

W. H. R. Report N: 8983.

1st 6 9001

over


Lloyd's Register