

SKETCH OF IRON LOWER MASTS.


SCALE $\frac{1}{4}$ " = 1 FOOT

MESSRS. FURNESS, WITHY, & CO'S NO 203.S.S


NOTE! BUTTS IN HOUSING & TOPMASTS DOUBLE RIVETED, REMAINDER
TREBLE, WITH STRAPS $\frac{1}{16}$ THICKER THAN PLATES THEY CONNECT.
SEAMS SINGLE RIVETED, RIVETS $\frac{1}{4}$ DIA, 5 DIAS APART.
MASTS TO CARRY FORE & AFT SAIL ONLY.

THOMAS SUDRON & Co., Limited
IMPERIAL BOILER WORKS,
STOCKTON-ON-TEES.

FOREMAST

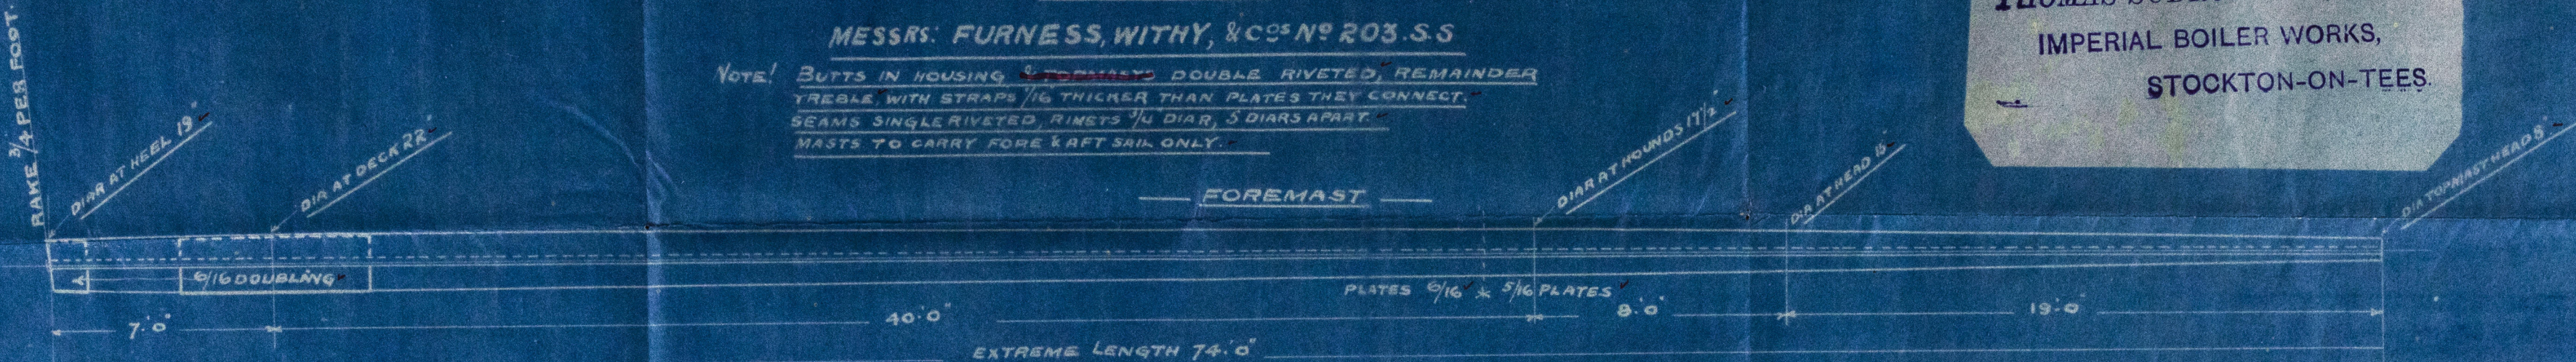

MAINMAST

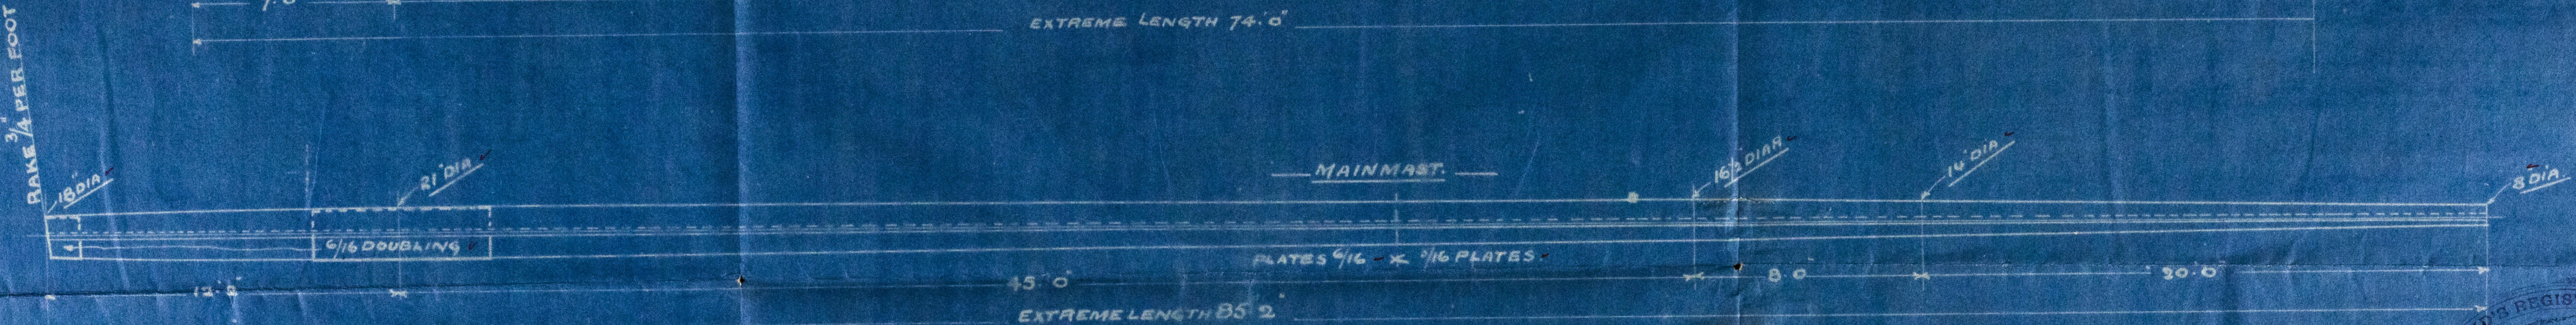

LR

HL 375-0095

Fast-Plan
No 203

S. S. Straits of Menai,
W. H. P. Report No. 9478.

HPL 373-0097

© 2019

Lloyd's Register
Foundation