


SCALE $\frac{1''}{4} = 1 \text{ FOOT}$

$\frac{L}{2}$ LENGTH

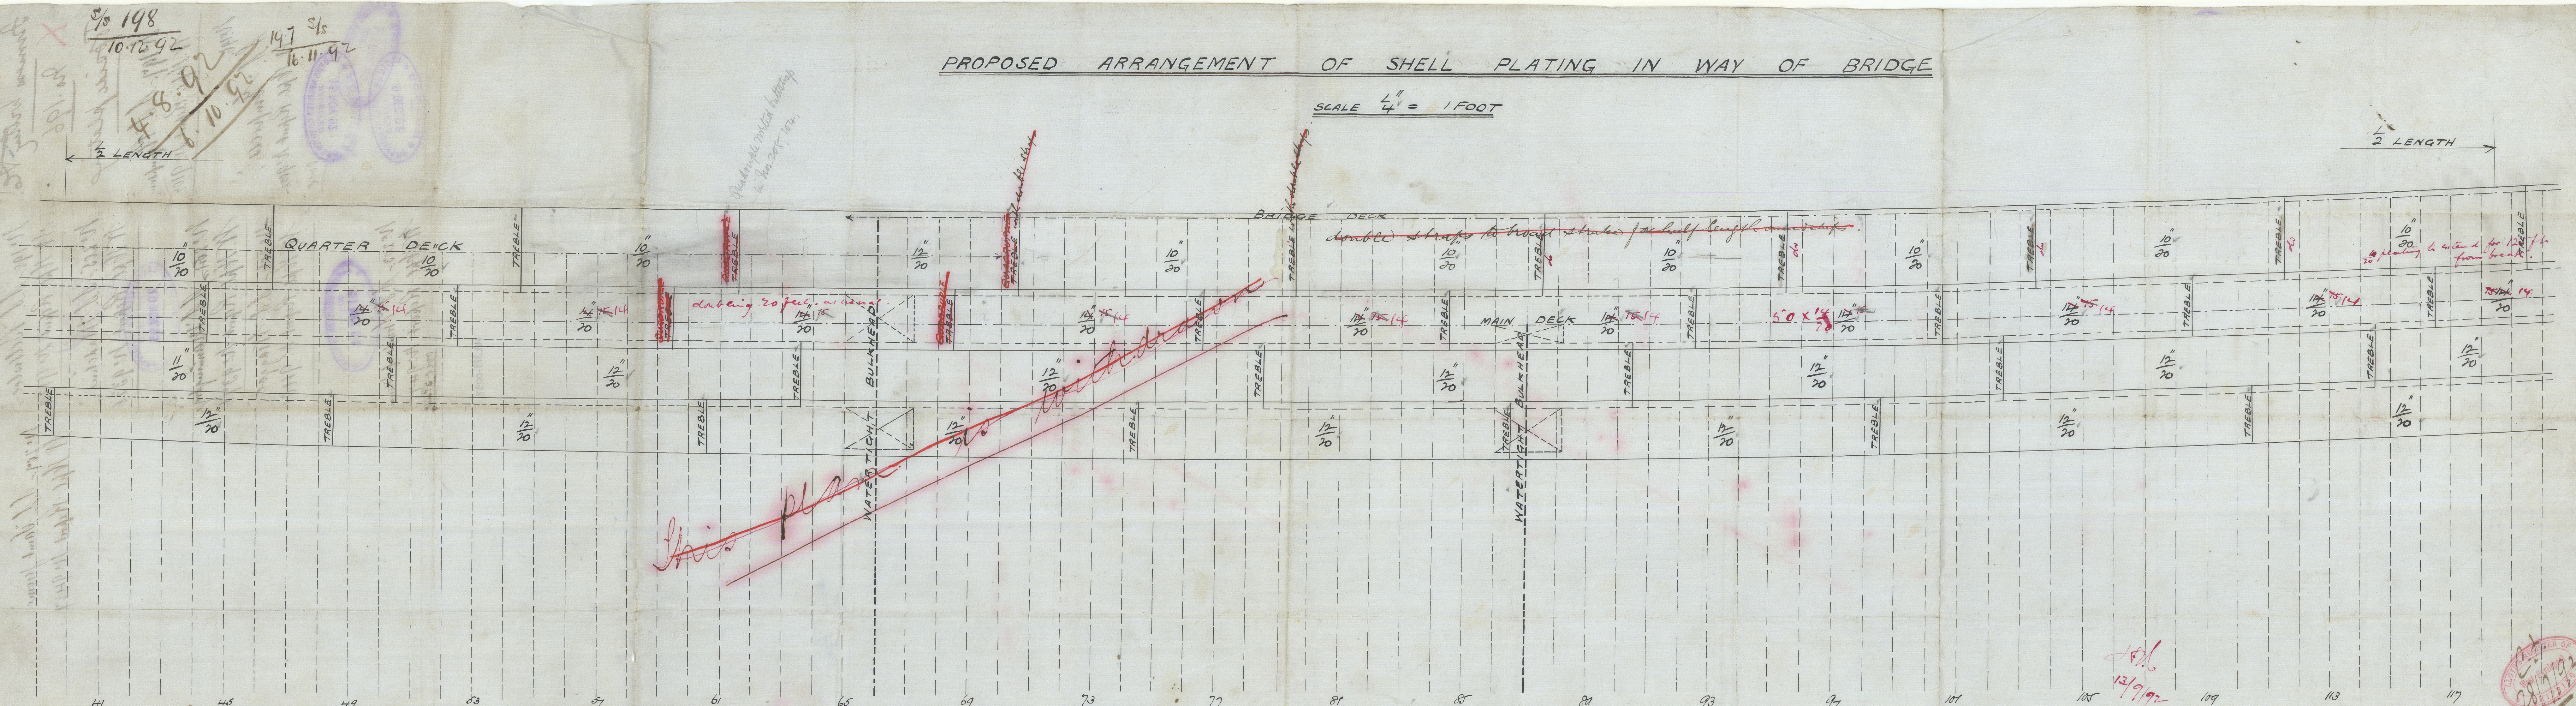

№ 196

FURNESS, WITHEY & CO. LIMITED.
SHIPBUILDERS & SHIPOWNERS,
WEST HARTLEPOOL.
19th July 1892
HPL373-0048

J. J. W. Co.
X No. 196

Top side plating

No. 197. S.S. Plymouth
W. Hpl. Report No. 9102

No. 196.
S.S. Empress
W. Hpl. Report No. 9004

No. 198. S.S. Reclusoe
W. Hpl. Report No. 9122

No. 205. S.S. Madeline
W. Hpl. Report No. 9336

No. 204. S.S. Manningtrey
W. Hpl. Report No. 9376

No. 206. S.S. Wraggoc
W. Hpl. Report No. 9401

No. 203. S.S. Stricks of Alenai
W. Hpl. Report No. 9478
over 2nd side

No. 207. S.S. Saint Jerome
W. Hpl. Report No. 9487

W. H. & Co. Ltd.
No. 196

1/3 24











© 2021

Lloyd's Register
Foundation