

197 <sup>4s</sup> 1/8 148  
 16.11.92 10.12.92  
 4.8.92  
 6.10.92  
 21.10.92

# MAIN DECK


RULE SIZE OF STRINGER  
 PROPOSED SIZE OF STRINGER

$$\begin{array}{l}
 44\frac{1}{2} \times \frac{12-8}{20} \\
 75 \times \frac{11-8}{20}
 \end{array}$$

SCALE  $\frac{1}{4}'' = 1 \text{ FOOT}$

$\frac{1}{2}$  LENGTH

$\frac{3}{5}$  LENGTH

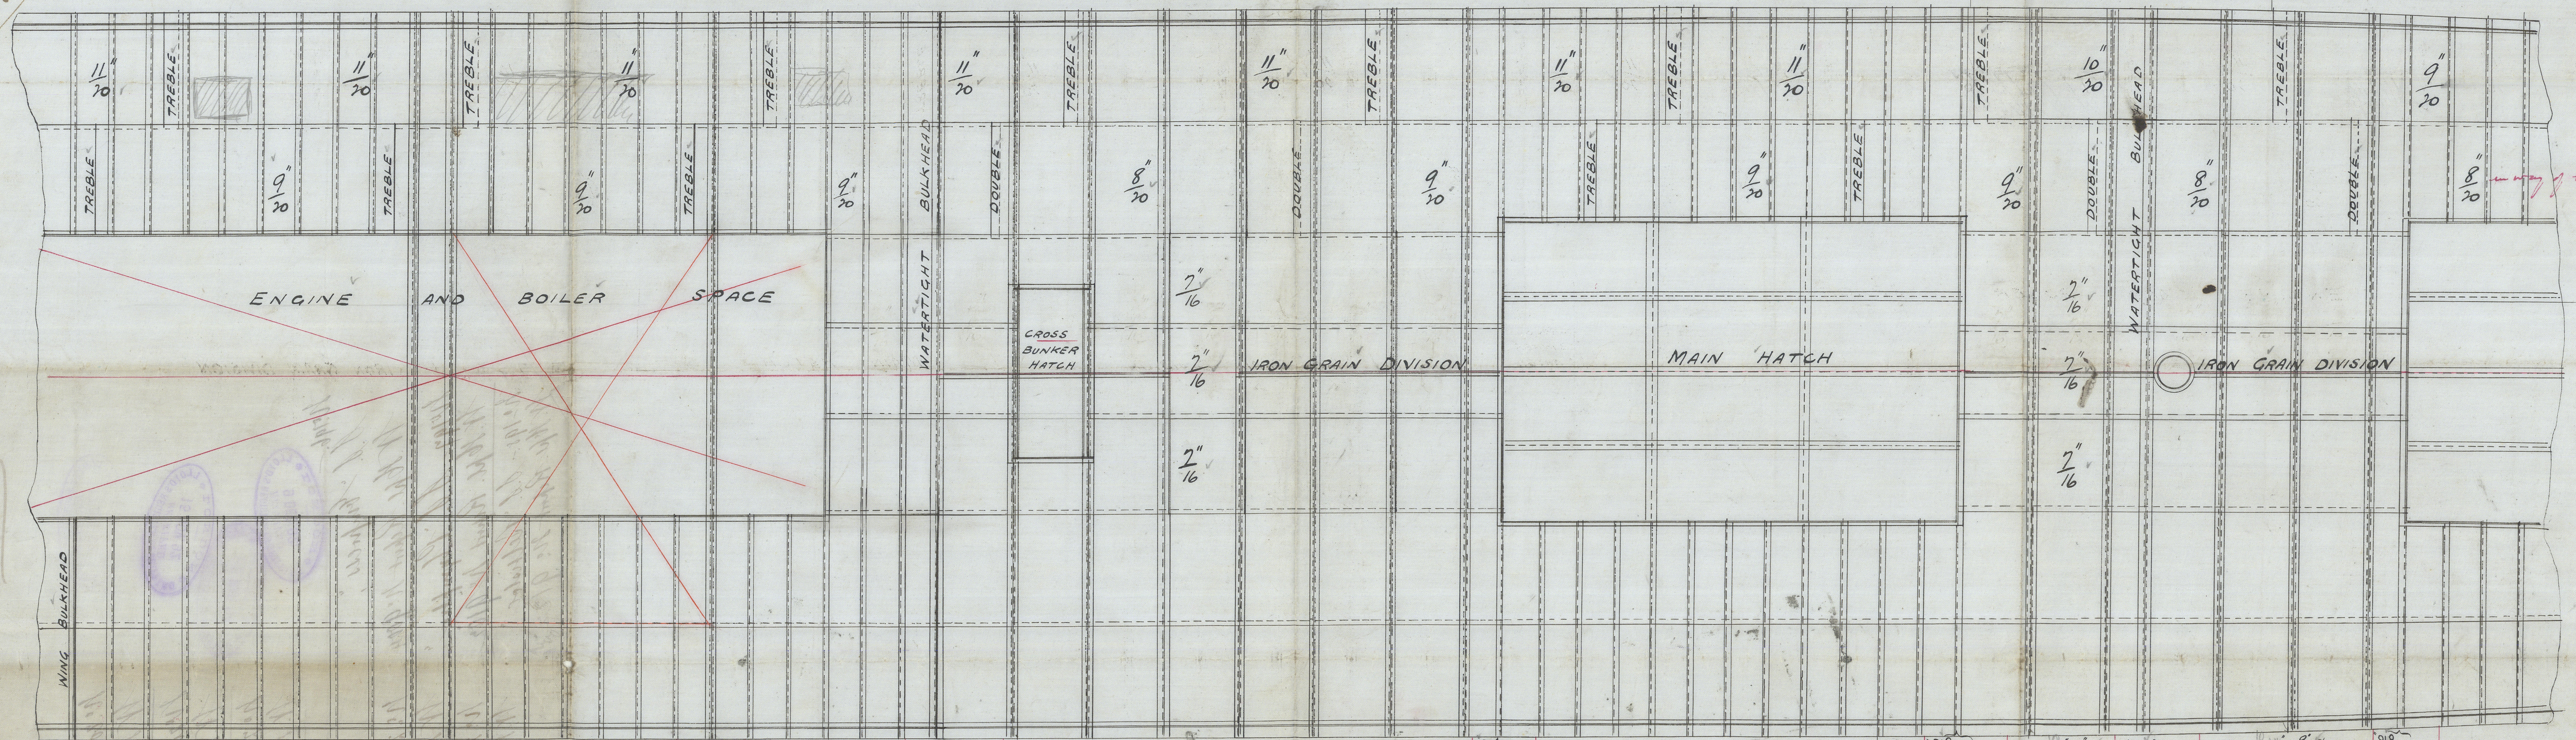

N<sup>o</sup> 196.

J.H.  
 6/10/92

FURNESS, WITHEY & CO., LIMITED.  
 SHIPBUILDERS & SHIPOWNERS,  
 WEST HARTLEPOOL.  
 18th July 1892



REGISTERED  
 28.7.92



Furness Witherby & Co

X No. 196

Grand deck

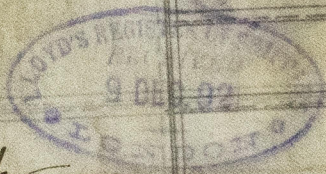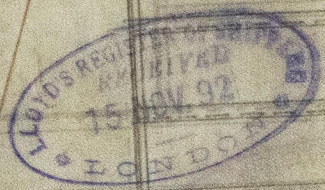

No 196.

S.S. "Compress";

W. Hpt. Report No 9004

No 197. S.S. "Plympton";

W. Hpt. Report No 9102

No 198. S.S. "Beltristoc";

W. Hpt. Report No 9122

No 205. S.S. "Madeline";


W. Hpt. Report No 9336

No 204. S.S. "Munnington";

W. Hpt. Report No 9376

No 206. S.S. "Wraggoc";

W. Hpt. Report No 9407

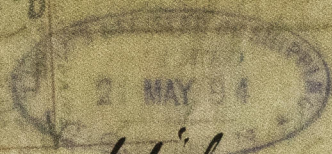

No 203. S.S. "Strada of Menai";

W. Hpt. Report No 9478

No 207. S.S. "Saint Jerome";

W. Hpt. Report No 9487

Lloyd's Register  
Foundation

HP2373-0099