


197 9/5 8/198  
 16.11.92 18.12.02  
 13.4.93 18.4.93  
 20.2.93 20.7.93  
 21.10.92

Nos 204, 205 and 206 } No 207  
 14.9.93. } approved  
 2.10.93.



FORNESS, WITBY & CO., LIMITED  
 SHIPBUILDERS & SHIPPOWERS,  
 WEST HARTLEPOOL  
 August 18, 1894

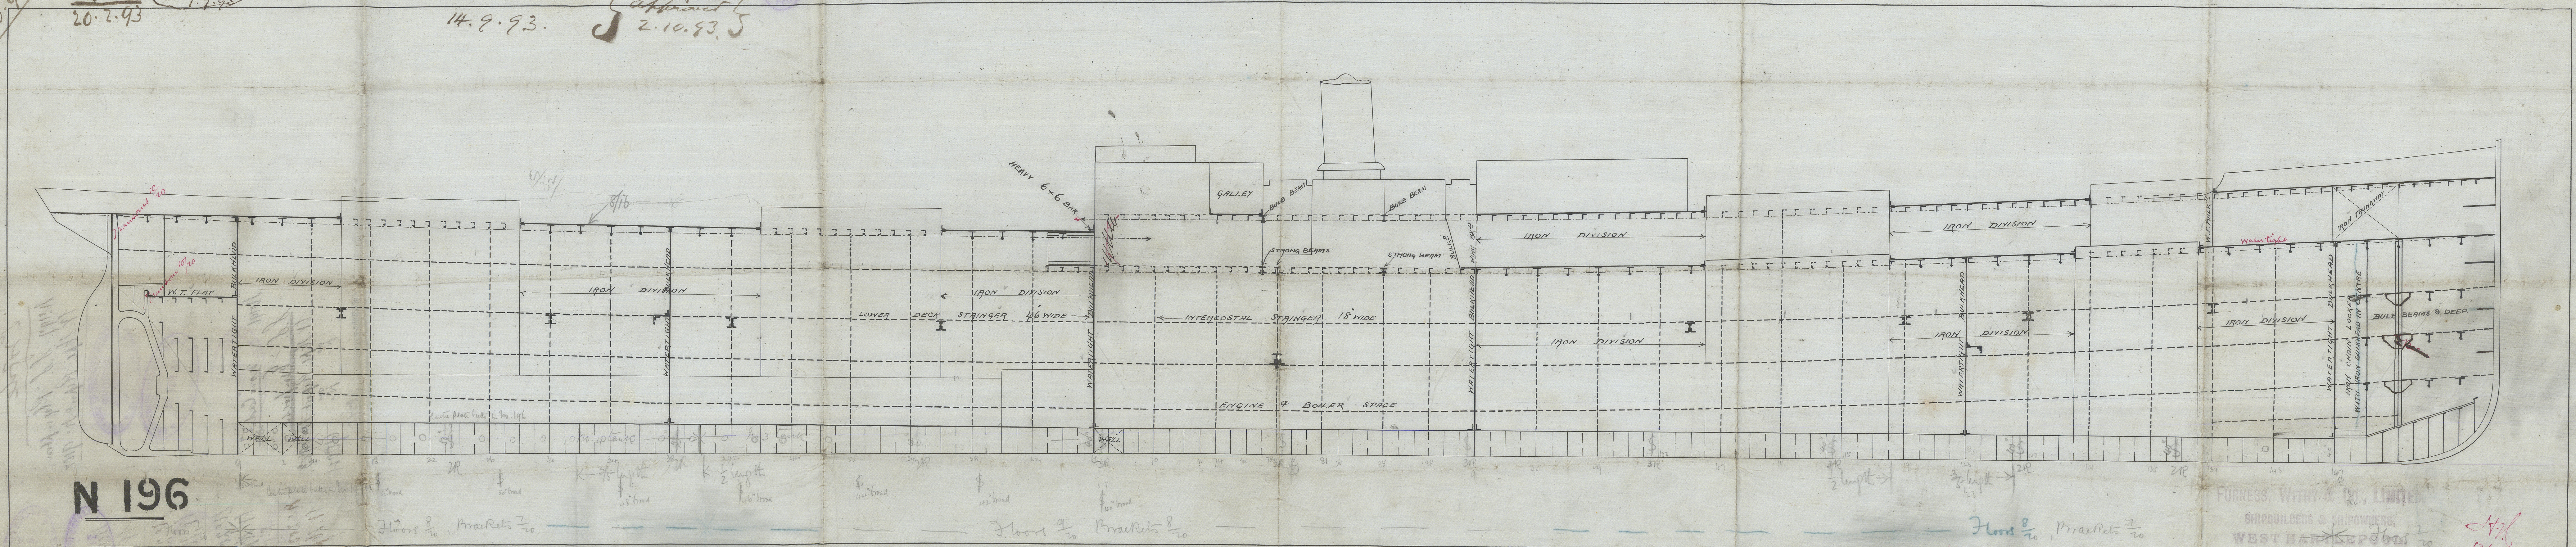

Furness Writing Co.

X No. 196.

Profile

No. 197. S.S. "Phympton",  
W. Hope. Report No. 9102




No. 196. now Cadiz

S.S. "Empress"

W. Hope. Report No. 8983.

No. No. 9004

HP1373-0105

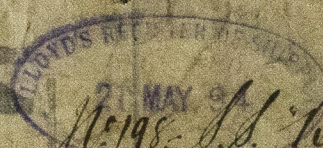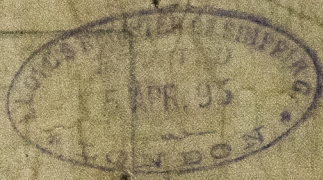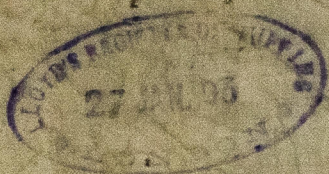

No. 198. S.S. "Bellisio"

W. Hope. Report No. 9102

No. 205. S.S. "Madeline"

W. Hope. Report No. 9336

No. 206. S.S. "Wraggoc"

W. Hope. Report No. 9378.

No. 1st Entry No. 9401

No. 203. S.S. "Strait of Menai"

W. Hope. Report No. 9409

No. No. 9478

Foundation