

Saint George

Received at WEST HARTLEPOOL Office.

21. 4. 1914

## Lloyd's Register of British and Foreign Shipping.

(Report on Vessel No. 9487 Port WEST HARTLEPOOL.)

No. 2711 a

## SHIP FORGINGS OR CASTINGS.

I have to report that the undermentioned Iron or Steel Forgings or Castings, manufactured by Messrs H. Gray & Co. of Newcastle for the Vessel No. 207, being built by Messrs. Furness Britny & Co. of Newcastle have been inspected by me as set forth below, and found to be, so far as can be seen, sound.

Mark on Forgings.

Lloyd's

No. 2711 a  
No. 6.

Hugh Cameron


Sunderland

20. 4. 1914

	STERN FRAME.	RUDDER FRAME.	STEM.
Material*	Scrap iron	Scrap iron	Scrap iron
How made	Forged	Forged	Forged
Dimensions	10" x 6"	8" x 4"	10" x 2 3/4"
Progress on Inspection	Forged & smithed	Forged & smithed	Forged
Date when Inspected	Jan'y 29 <sup>th</sup> to Feb'y 23/1914	Feb'y 23 <sup>rd</sup> to April 19/1914	Feb'y 19/1914

SKETCHES OF FIGURES SHOWING POSITION AND DESCRIPTION OF WELDS OF FORGINGS, OR PARTICULARS OF TESTS APPLIED TO CASTINGS.

Welds

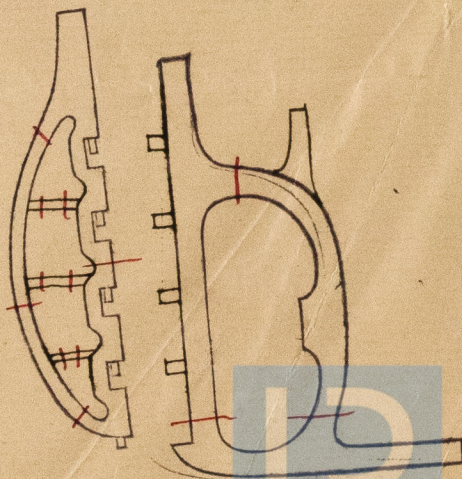

HPL373-0118(12)

\* If of Iron, state whether scrap or puddled Iron.