

# Lloyd's Register of British and Foreign Shipping.

(Report on Vessel No. 9514 Port WEST HARTLEPOOL.)

No. 2712a.

## SHIP FORGINGS OR CASTINGS.

I have to report that the undermentioned Iron or Steel Forgings or Castings, manufactured by The Darlington Forge Co. & Richardson Sons of Darlington & Hartlepool for the Vessel No. 208, being built by Messrs. Furness Withy & Co. of Hartlepool have been inspected by me as set forth below, and found to be, so far as can be seen, sound.

Mark on Forgings.

Lloyd's


No. 2712a  
W.C.

W. Hugh Cameron

Sunderland  
9-6-94  
J. Richardson Sons

	STERN FRAME.	RUDDER FRAME.	STEM.
Material* ...	<u>Scrap iron</u>	<u>Scrap iron</u>	<u>Scrap iron</u>
How made ...	<u>Forged</u>	<u>Forged</u>	<u>Forged</u>
Dimensions ...	<u>10" x 5 1/2"</u>	<u>7 3/4" x 3 3/4"</u>	<u>10" x 2 1/2"</u>
Progress on Inspection	<u>Forged &amp; smithed</u>	<u>Forged &amp; smithed</u>	<u>Forged</u>
Date when Inspected	<u>July 8<sup>th</sup> to March 9/94</u>	<u>April 5<sup>th</sup> to May 21/94</u>	<u>July 26/94</u>

SKETCHES OF FRAMES SHOWING POSITION AND DESCRIPTION OF WELDS OF FORGINGS, OR PARTICULARS OF TESTS APPLIED TO CASTINGS.

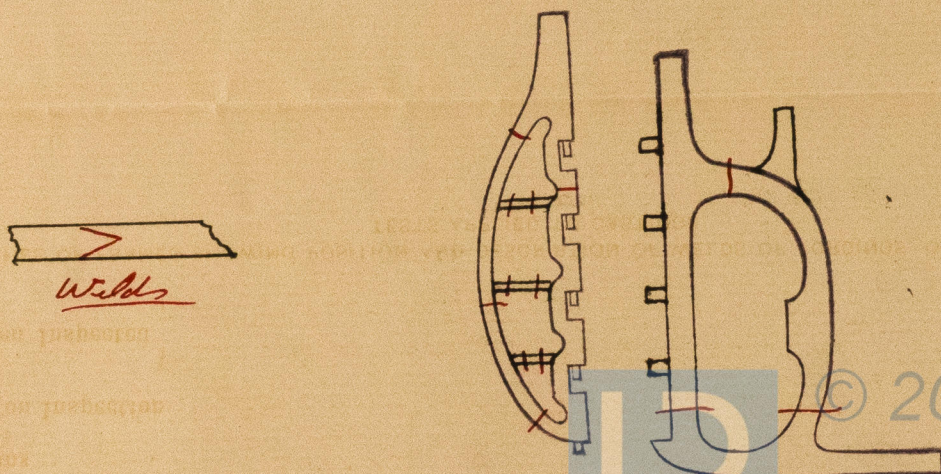

\* If of Iron, state whether scrap or puddled Iron.