


STRINGER AS FITTED  $7\frac{1}{2} \times \frac{1}{20}$   
RULE SIZE  $4\frac{1}{4} \times \frac{1}{20}$

# QUARTER DECK

# BRIDGE DECK

STRINGER AS FITTED  $7\frac{1}{2} \times \frac{1}{20}$   
RULE SIZE  $4\frac{1}{4} \times \frac{1}{20}$


18.5.94  
8.10.94  
16.10.94

 


STRINGER AS FITTED  $7\frac{1}{2} \times \frac{1}{20}$   
RULE SIZE  $4\frac{1}{4} \times \frac{1}{20}$

# MAIN DECK

With your notes  
W. J. J. J.

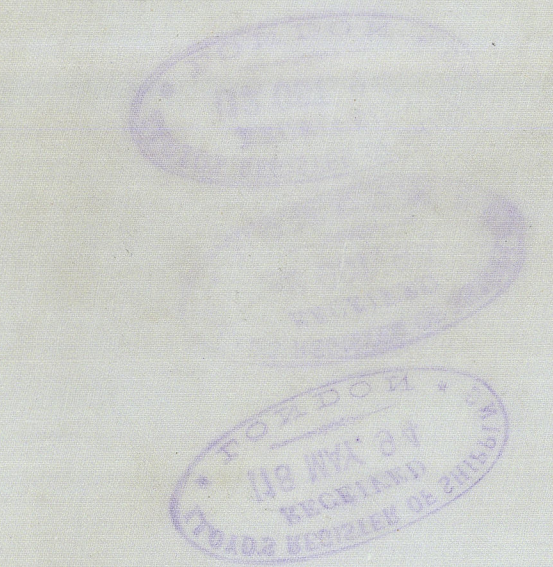

Drawn by  
Wm. J. J.  
18.10.94

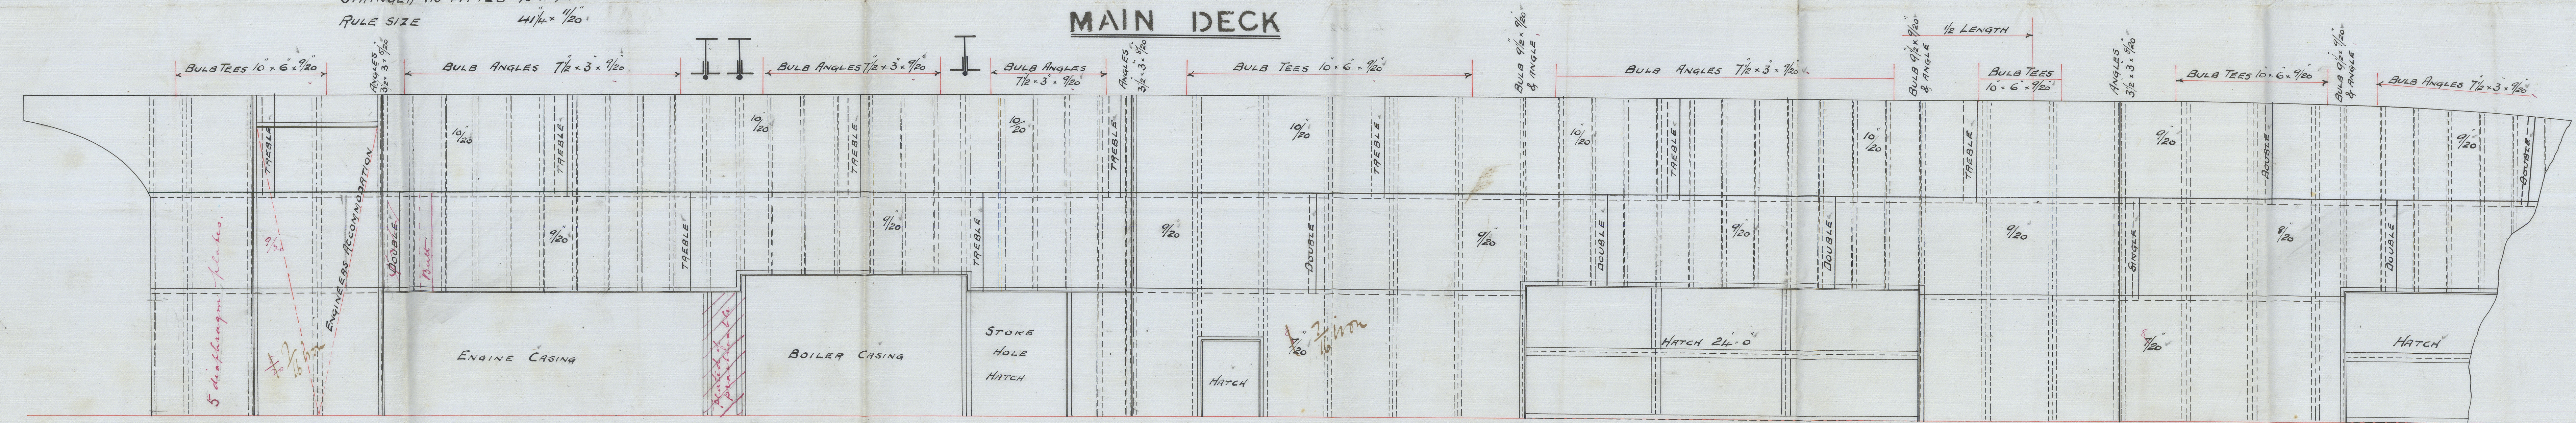

N 208

18/10/94




Furness Withy & Co.  
No. 208

Main, Bridge, and  
Quartern ak. plans



S. J. Bindall,  
W. Mpl. Report No. 9514

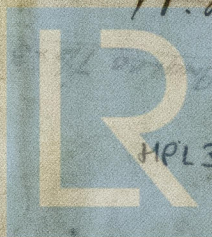

MP1373-0149

Lloyd's Register  
Foundation