


23. 1. 94.
24. 4. 94
13. 7. 94
17. 7. 94
7. 8. 94
8. 10. 94
10. 10. 94

PROFILE.
IRON VESSEL.

FURNESS, WITBY & Co., LIMITED.
SHIPBUILDERS & REPAIRERS,
WEST HARTLEPOOL.
JANUARY 12TH 1894.

FRAMES OF BULB ANGLE SECTION CARRIED UP IN ONE LENGTH FROM TANK SIDE.

*Break to shifted 4 frames aft
engine opening and deck scupper
frame space.*

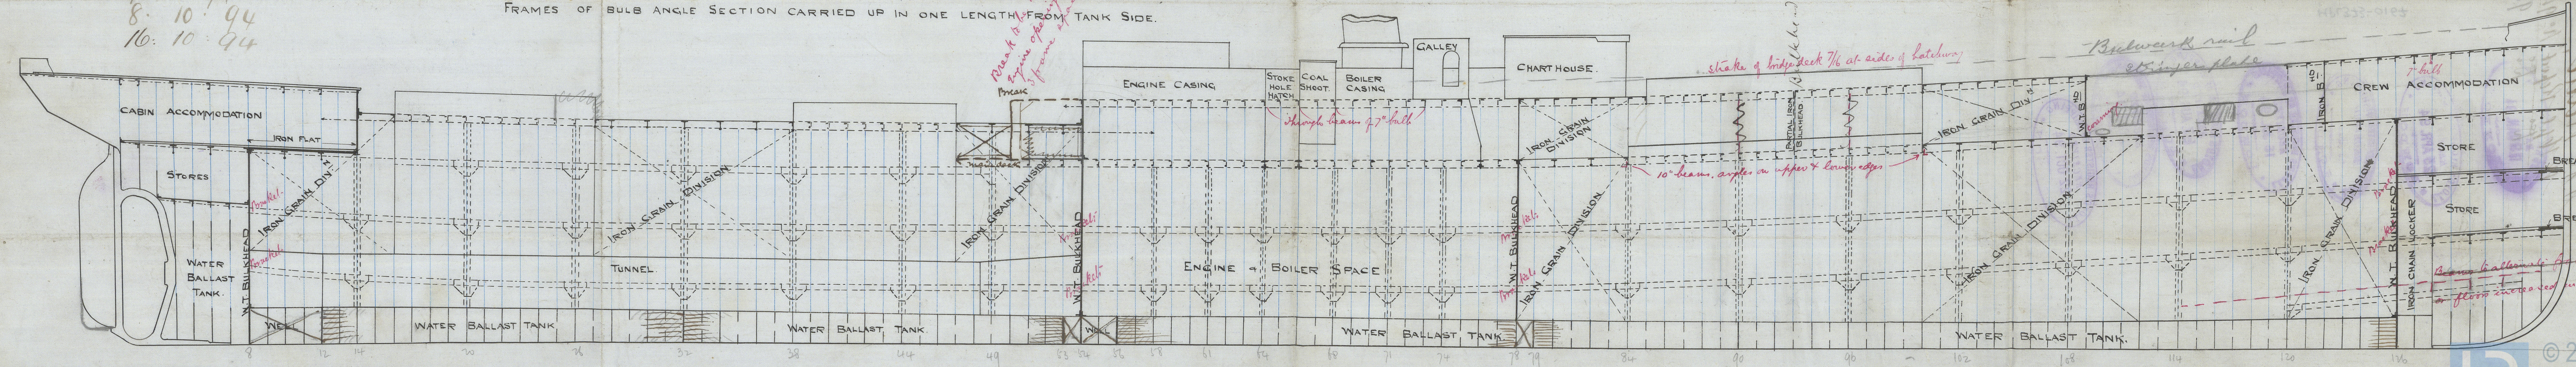

S. S. N° 209.


16/7/94
39/1/94

Furness Withy & Co.
no 209

Profile.

S. S. Nellie

W. H. Report No 9488
9575

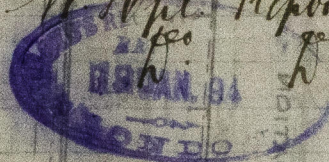

HPL373-0167

JOHN H. LEEBOO
GENERAL MANAGERS
FURNESS WITHY & CO. LIMITED



© 2021
Lloyd's Register
Foundation