

*S. J. Helle*

Received at **WEST HARTLEPOOL** Office, 19<sup>th</sup> May 1894

# Lloyd's Register of British and Foreign Shipping.

(Report on Vessel No. 9525 Port WEST HARTLEPOOL.)

*Wpool*

No. 2713.a

## SHIP FORGINGS OR CASTINGS.

The words FORGINGS or CASTINGS, IRON or STEEL, should be struck out as may be required.

I have to report that the undermentioned Iron ~~or Steel~~ Forgings ~~or Castings~~, manufactured by *Wheeler & Ray Co.* of *Warrington* for the Vessel No. *209*, being built by *Wheeler & Ray Co.* of *Warrington* have been inspected by me as set forth below, and found to be, so far as can be seen, *sound*.

Mark on Forgings.


Lloyd's  
No. 2713.a  
*W.C.*

*Rough Cameron*  
*Sunderland.*

18.5.94

	STERN FRAME.	RUDDER FRAME.	STEM.
Material*	<i>Scrap iron</i>	<i>Scrap iron</i>	<i>Scrap iron</i>
How made	<i>Forged</i>	<i>Forged</i>	<i>Forged</i>
Dimensions	<i>9" x 5 1/2"</i>	<i>7" x 3 1/2"</i>	<i>9" x 2 1/2"</i>
Progress on Inspection	<i>Forged &amp; Smithed</i>	<i>Forged &amp; Smithed</i>	<i>Forged</i>
Date when Inspected	<i>July 8<sup>th</sup> to March 9/94</i>	<i>March 14<sup>th</sup> to May 11/94</i>	<i>July 21/94</i>

SKETCHES OF FRAMES SHOWING POSITION AND DESCRIPTION OF WELDS OF FORGINGS, OR PARTICULARS OF TESTS APPLIED TO CASTINGS.

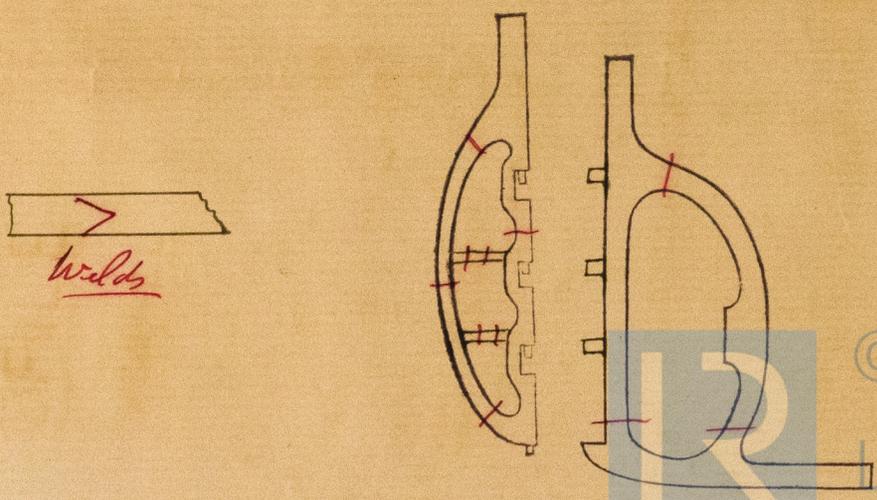

© 2019

Lloyd's Register  
Foundation

\* If of Iron, state whether scrap or puddled Iron.