

7. 2. 94



SKETCH OF IRON LOWERMASTS

SCALE 1/4" = 1 FOOT

MESSRS. FURNESS, WITHY, & CO. NO 209. S.S.

NOTE! BUTTS IN HOUSING & TOPMASTS DOUBLE RIVETED, REMAINDER TREBLE, WITH STRAPS 1/16 THICKER THAN PLATES THEY CONNECT. SEAMS SINGLE RIVETED, 3/4 RIVETS, 5 DIARS APART.

Fore and aft sail only.

RAKE 1/2 PER FOOT

HEEL DIAR - 17"

DECK DIAR 22 1/2"


FOREMAST



RAKE 1/2 PER FOOT

Distance between partners & deck 19'-6"

MAINMAST

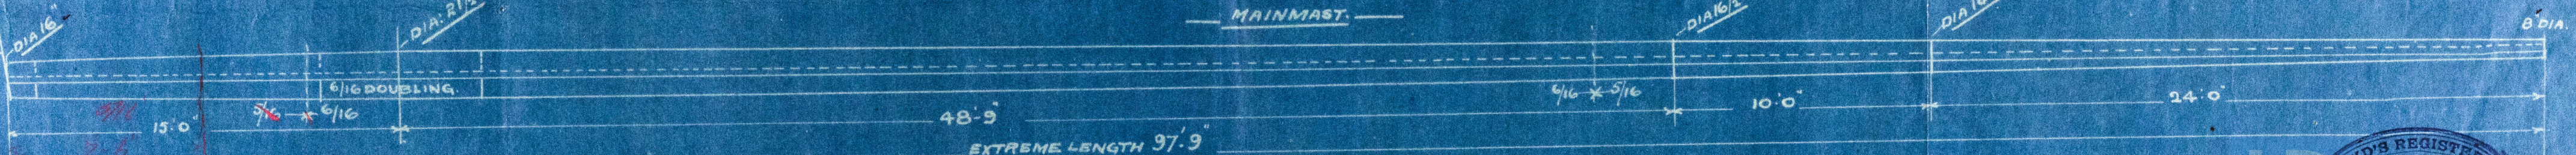

Distance between partners & deck 21'-4"

W.H.
7/2/94



2/2/94

Maat-Pan.
Furness Withy & Co
No 209



S.S. "Nellie",
W. Ship. Report No 9525

HPL393-0171



© 2021

Lloyd's Register
Foundation

HPL393-0171