


SKETCH OF PLATING IN FORE WELL.


SCALE $\frac{1}{4}$ INCH TO THE FOOT.

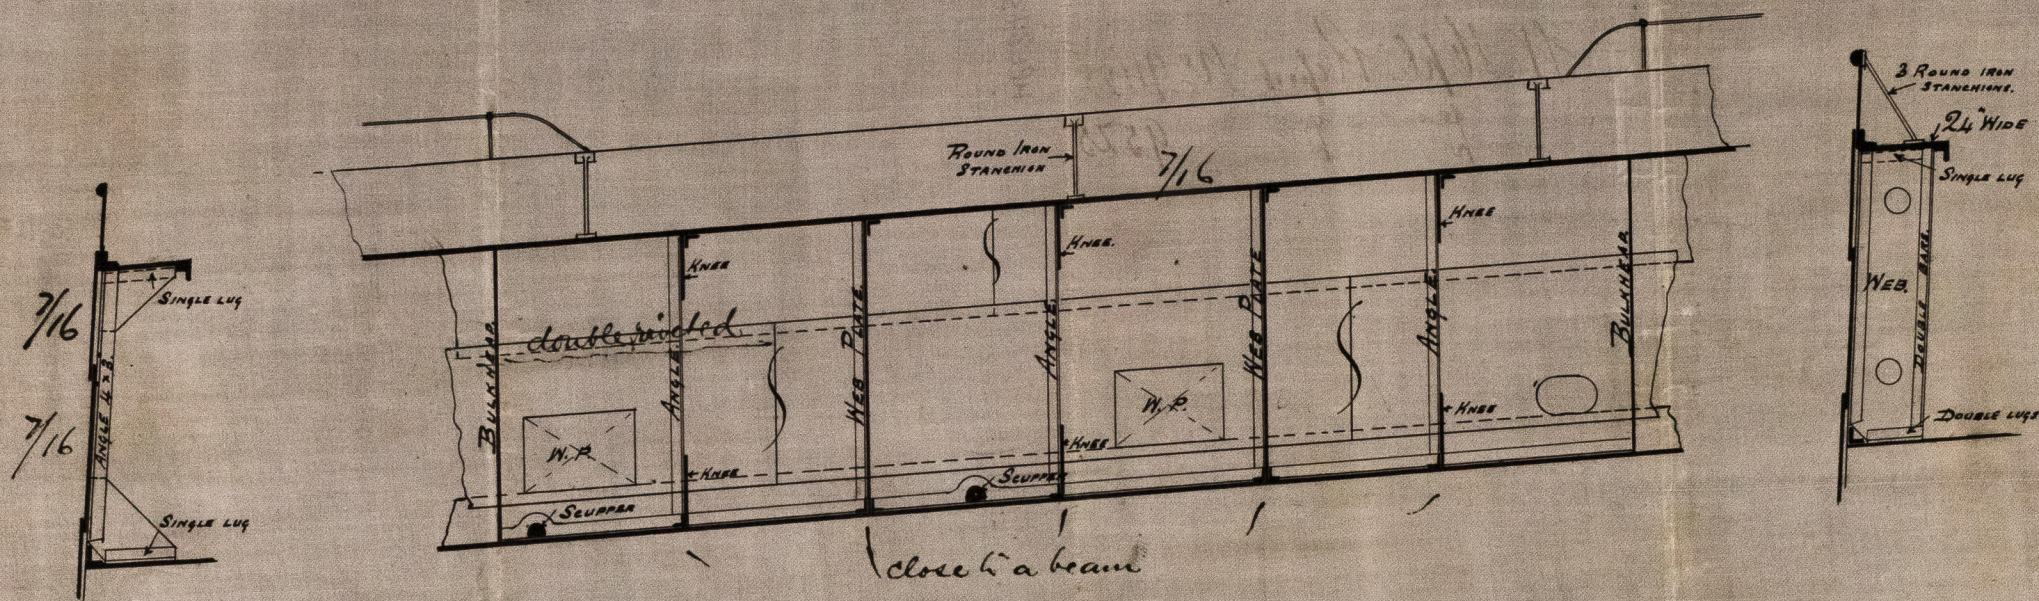

No 209

FURNESS, WITBY & CO., LIMITED.
 JAN 26th 94.
 SHIPBUILDERS & REPAIRERS.
 WEST HARTLEPOOL.

30/1/94

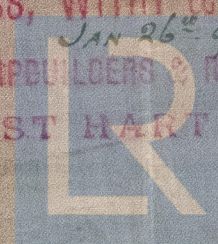

Lloyd's Register
 Foundation
 HPL373-0172

Furness Withy & Co.
No. 209



Framing at Sides
of well.

S.S. "Nellie",

W. Hpl. Report No 9488


HPL373-0172

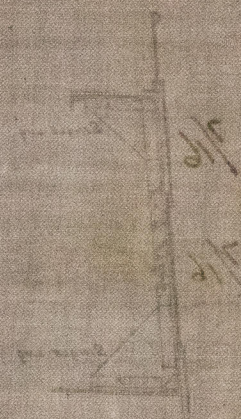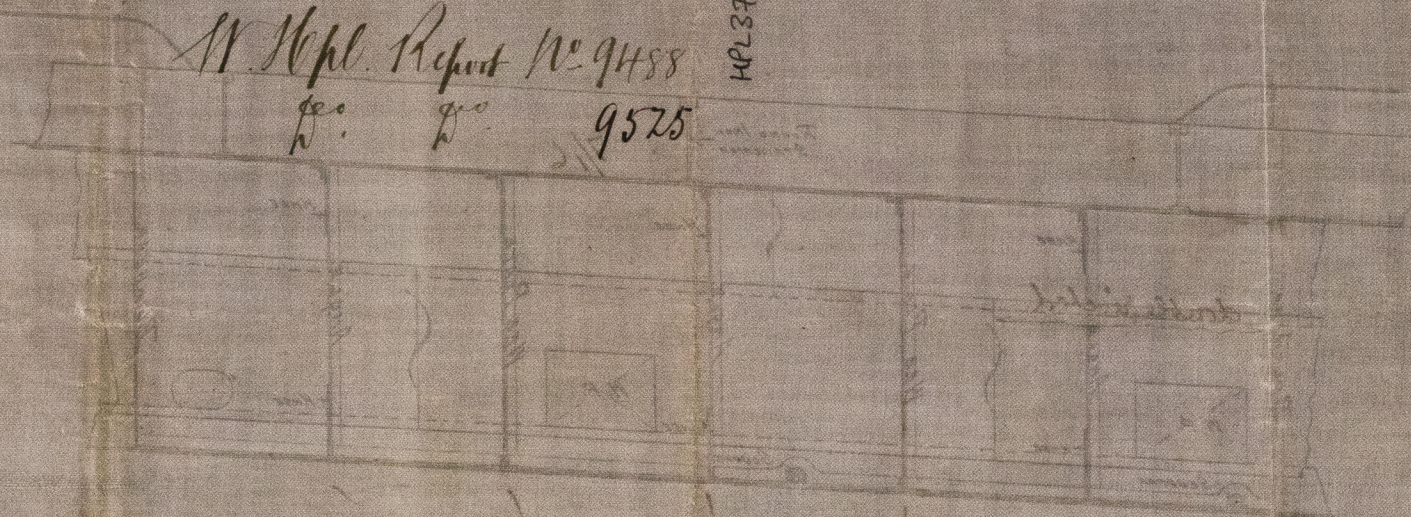

FURNESS, WITHY & CO. LIMITED

SHEDDING

WELL HEAD



© 2019

Lloyd's Register
Foundation