



BRIDGE DECK

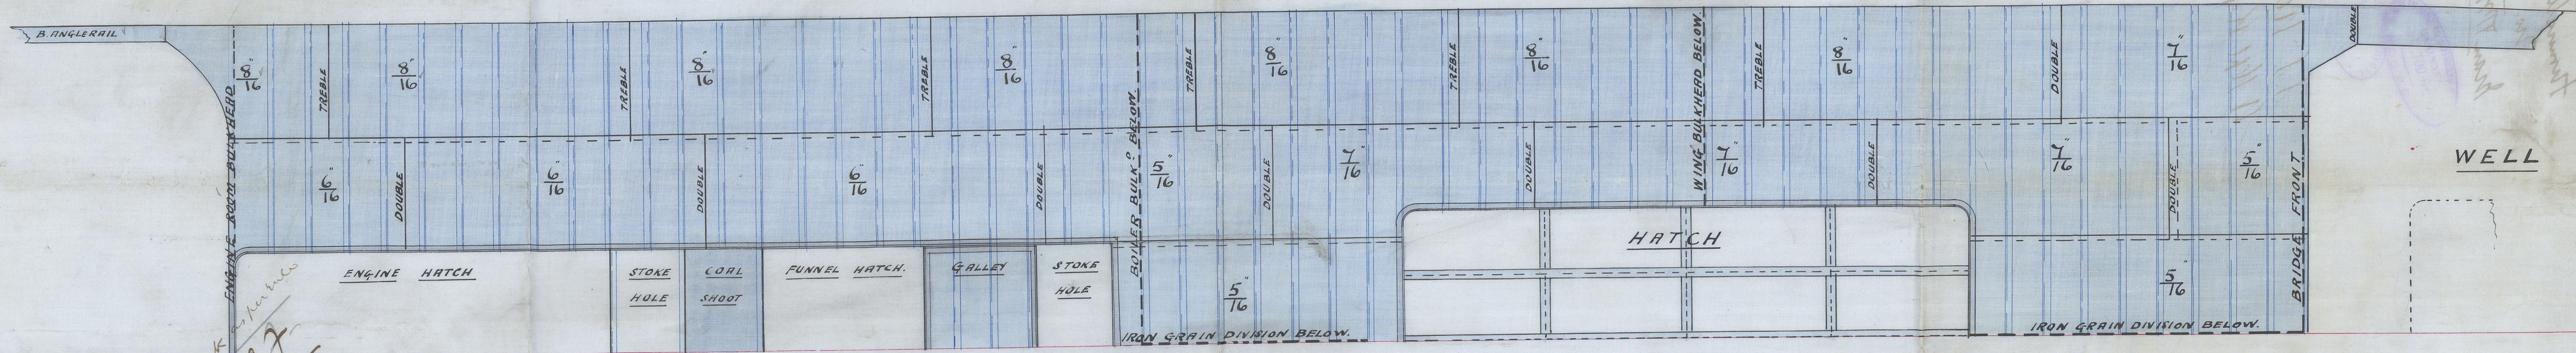

Rebuilt bulk as per rule
CT

MAIN DECK

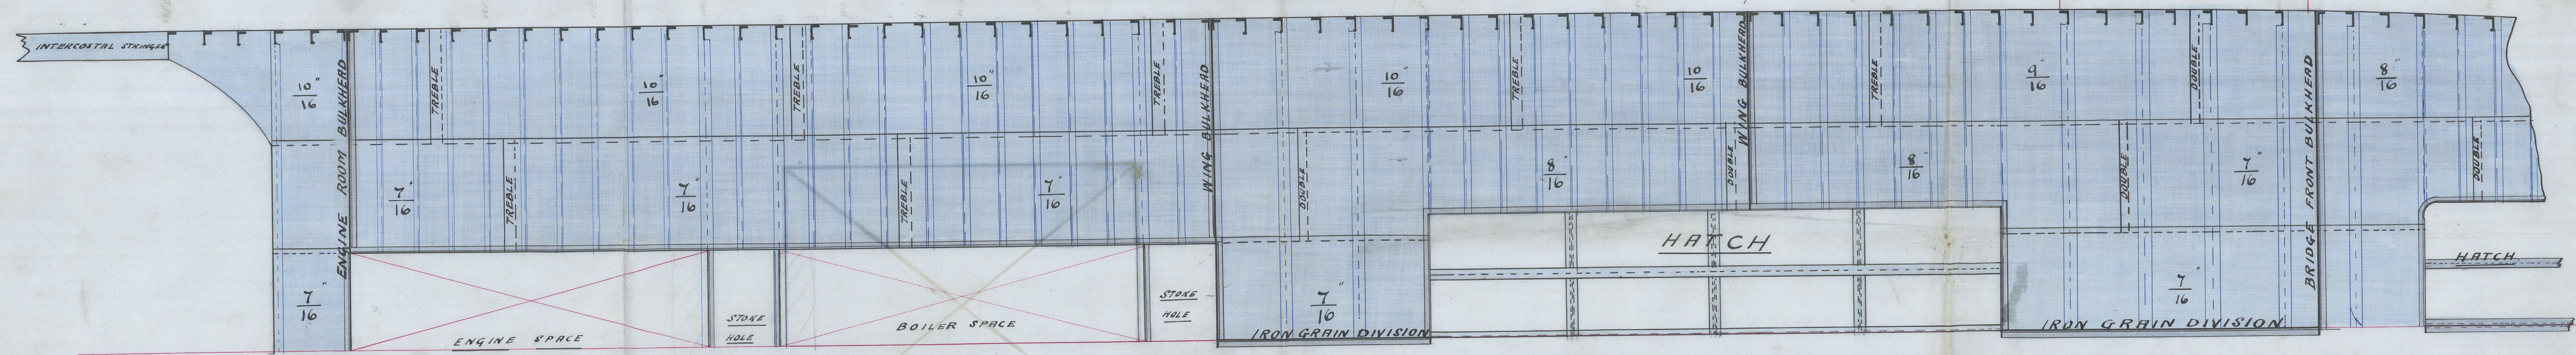

$\frac{1}{2}$ LENGTH
 $\frac{3}{5}$ LENGTH

IRON VESSEL No 209

FURNESS, WITBY & Co., LIMITED.
 SHIPBUILDERS & REPAIRERS,
 WEST HARTLEPOOL.

J.H.
30/1/94

TRACING No 11841.
 JAN 22 1894
 Lloyd's Register
 Foundation

Furness Writing & Co.

No. 209

Main W. Bridge dk. plans.

WEST



S.S. "Wellie",
W. Hpl. Report No. 9525

HPL373-0174



© 2021

Lloyd's Register
Foundation