
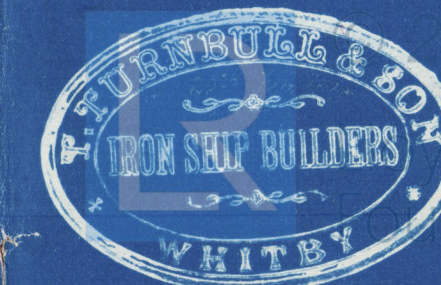


26.2.94

LONGITUDINAL SECTION

Nº 136

SCALE 1/8" = ONE FOOT

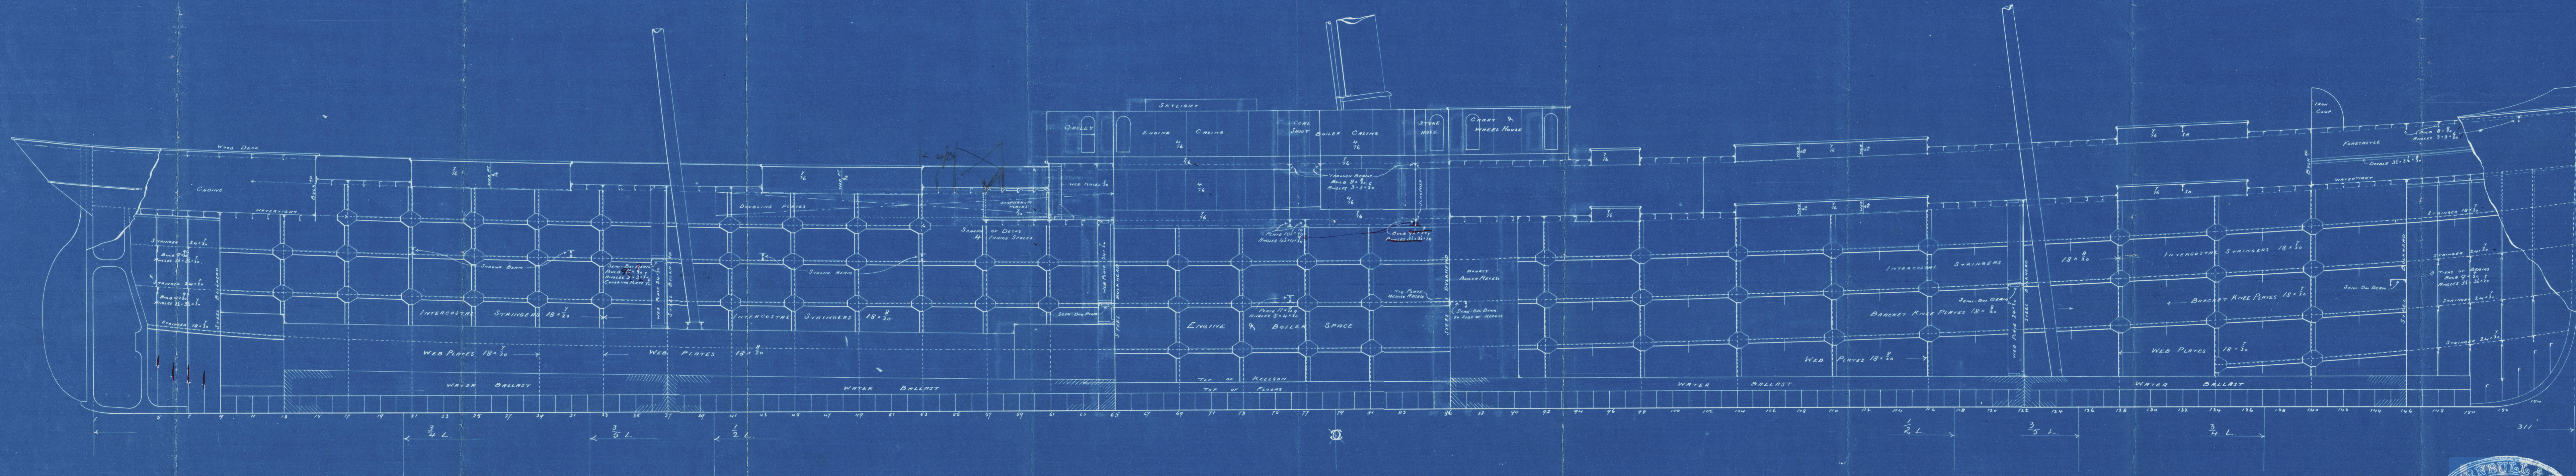

Register of Shipping

HPL374-0005



J. Turnbull & Co

No. 126

Profile



S.S. "Phoebe",

W. Hpl. Report No. 9537

No.

No.

9545

HL 374-0005



© 2020

Lloyd's Register  
Foundation