


203-08

J. Turnbull & Sons  
No. 126  
Diamond plate  
Connection.



LLOYD'S REGISTER OF SHIPPING  
RECEIVED  
20 MAR 1944


S.S. "Phaebé"  
W. Hpl Report No 9545  
HX 374-0007

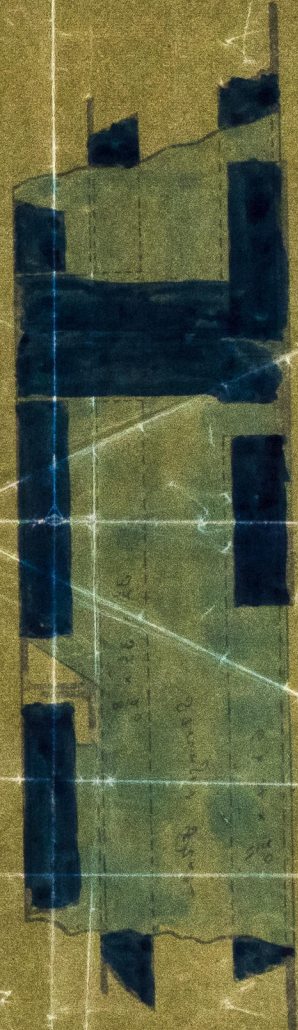

© 2019  
Lloyd's Register  
Foundation






20.3.94

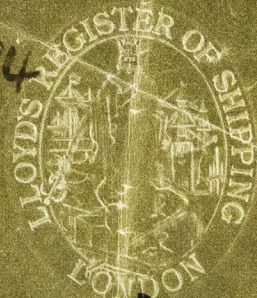

- No 126 sp. -

- Sketch showing Diamond Plate re. -

Scale 1" = one foot

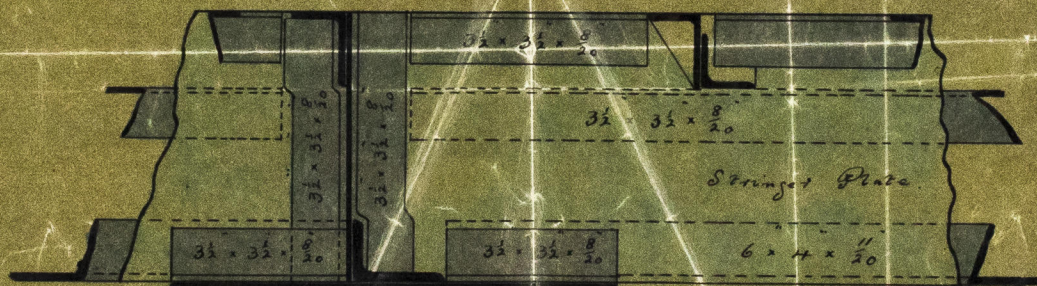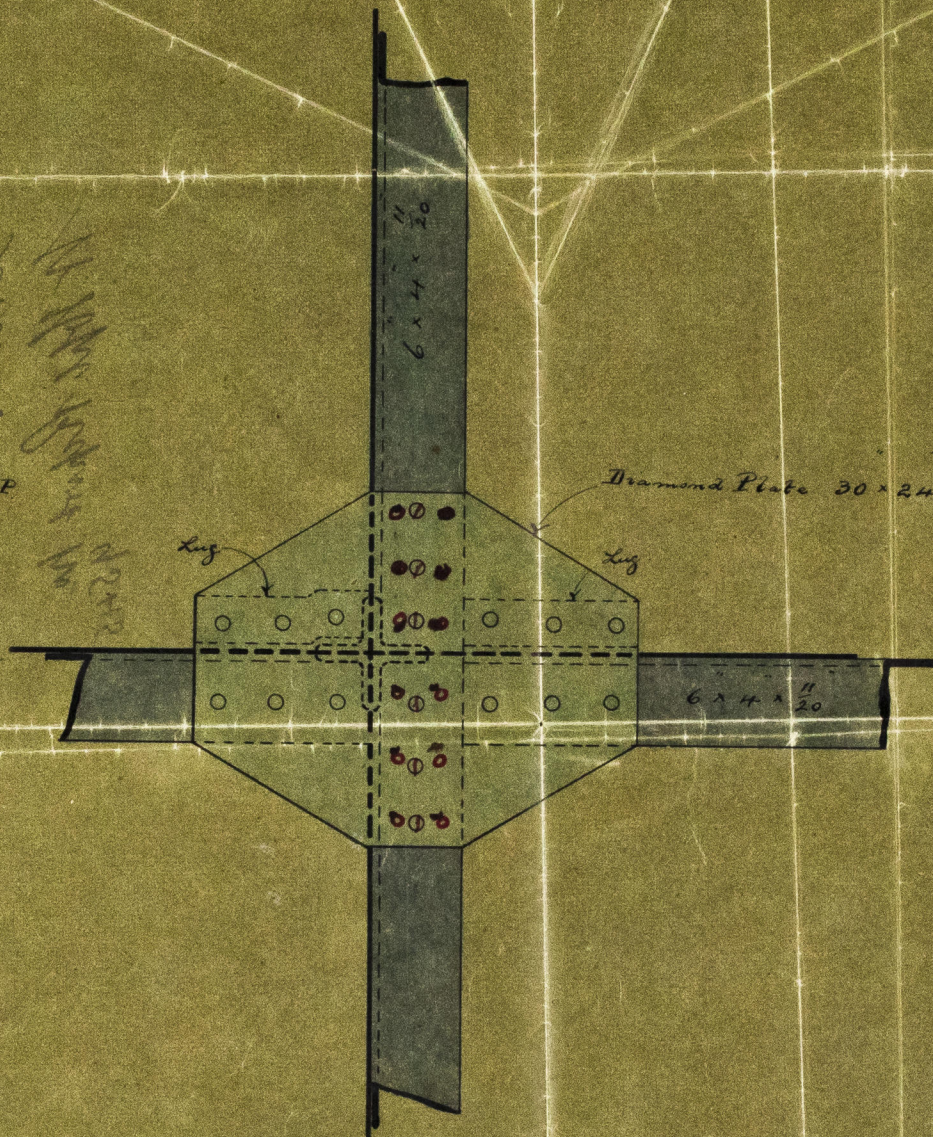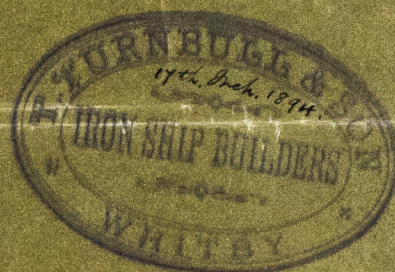

© 2019

Lloyd's Register  
Foundation