

*B. S. Lescauld*

Received at **WEST HARTLEPOOL** Office.

*21<sup>st</sup> June 1894*

# Lloyd's Register of British and Foreign Shipping.

*Wpool* (Report on Vessel No. *9576* Port **WEST HARTLEPOOL** )

## No. *2452 a*. SHIP FORGINGS OR CASTINGS.

I have to report that the undermentioned Iron or Steel Forgings or Castings, manufactured by *Woolf & Gray Co.* of *Wartlepool* for the Vessel No. *488*, being built by *Woolf & Gray Co.* of *Wartlepool* have been inspected by me as set forth below, and found to be, so far as can be seen, *sound*

The words FORGINGS or CASTINGS, IRON or STEEL, should be struck out as may be required.

HPL374-0072

Mark on Forgings.


Lloyd's  
No. *2452 a*  
*W.C.*

*Hugh Cameron*  
*Sunderland*

*20-6-94*

	STERN FRAME.	RUDDER FRAME.	STEM.
Material*	<i>Scrap iron</i>	<i>Scrap iron</i>	<i>Scrap iron</i>
How made	<i>Forged</i>	<i>Forged</i>	<i>Forged</i>
Dimensions	<i>11" x 6"</i>	<i>8 1/2" - 4 1/4"</i>	<i>10 1/2" x 2 3/4"</i>
Progress on Inspection	<i>Forged &amp; Smithed</i>	<i>Forged &amp; Smithed</i>	<i>Forged</i>
Date when Inspected	<i>July 26<sup>th</sup> to March 30/94</i>	<i>April 19<sup>th</sup> to June 12/94</i>	<i>March 30/94</i>

SKETCHES OF FRAMES SHOWING POSITION AND DESCRIPTION OF WELDS OF FORGINGS, OR PARTICULARS OF TESTS APPLIED TO CASTINGS.

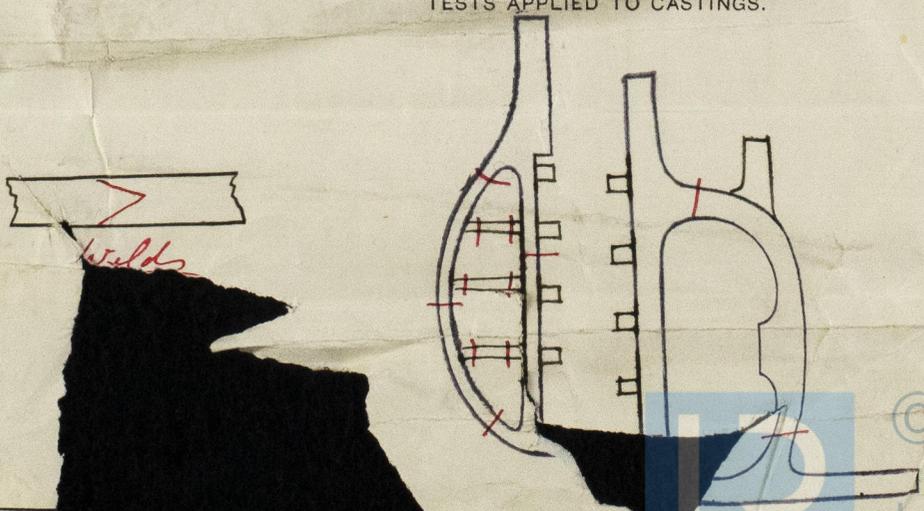

© 2019

Lloyd's Register Foundation