

83822 } 8/18
83822 }

Fumess Mithay 16/7

N° 212 Vessel


8000⁰ pressure

Sp. Ras Rona

Index report No 1433

W. Hpt. Report No 9620

HPL374-0146

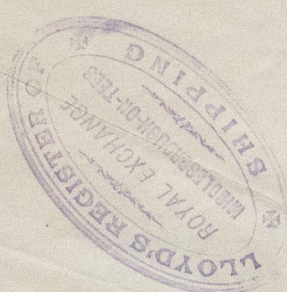

© 2019

Lloyd's Register
Foundation



VERT^L STEEL BOILER

14'0" x 7'0"

SCALE 1 INCH TO A FOOT

WORKING PRESSURE = 80 LBS "H"


MESS^{RS} FURNESS WILCOX & CO LIMITED

212
N^o 136 S.S.

To Pass Lloyds Survey

for 80 lbs w.p.

Length 14'0"

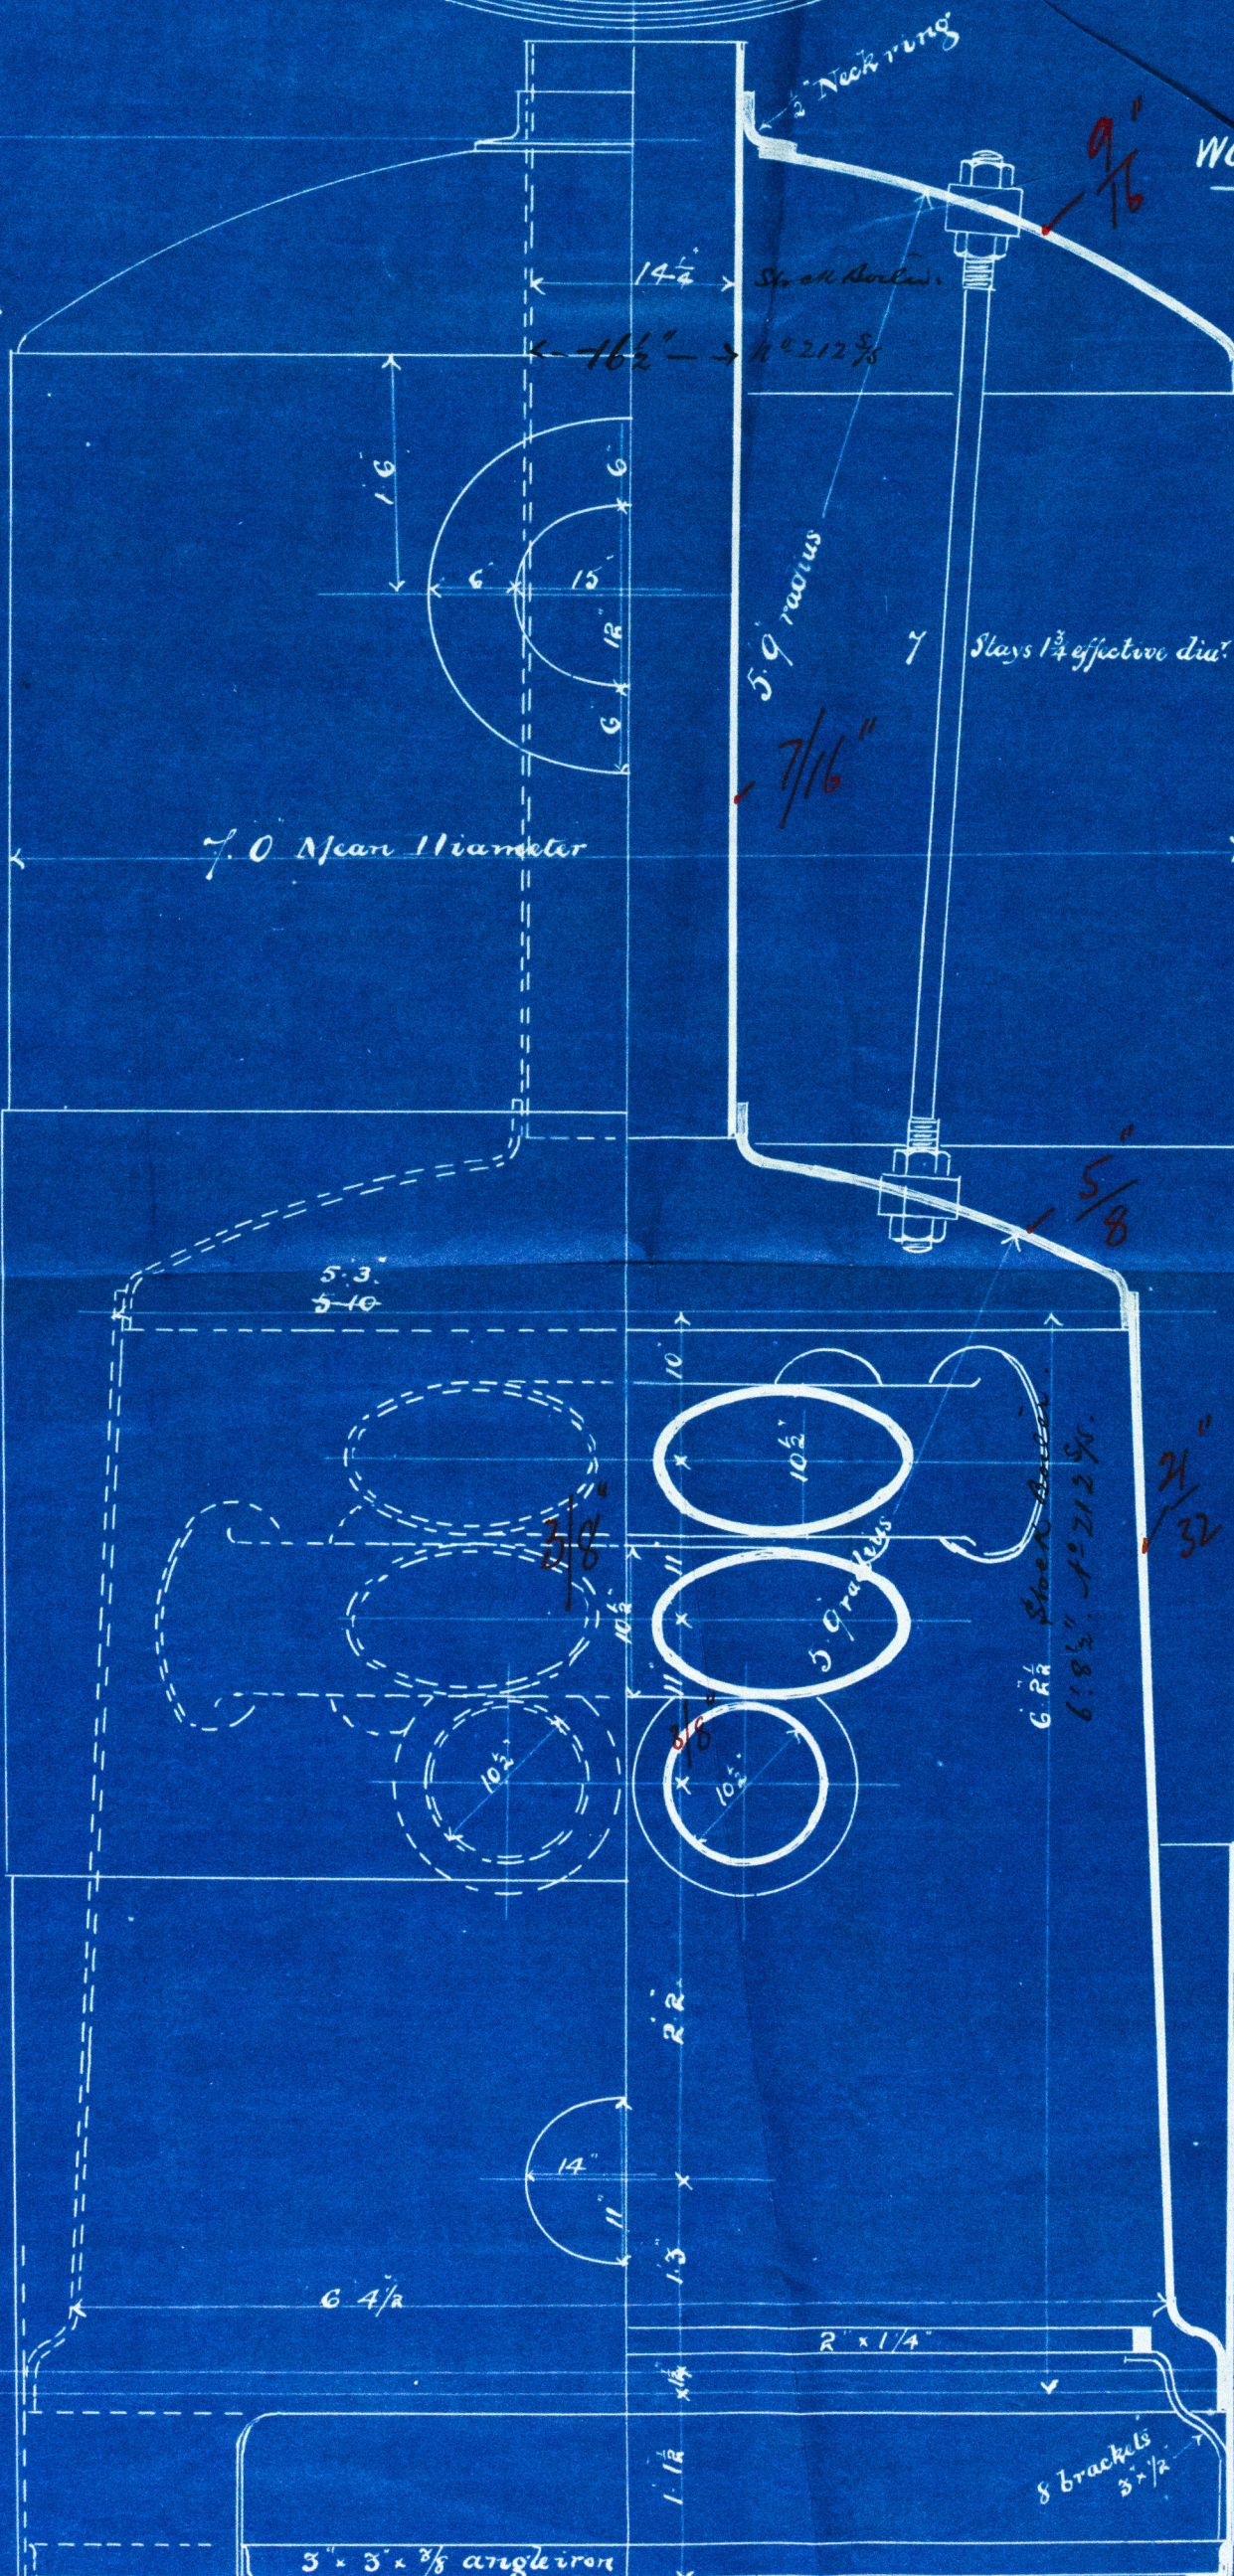

1 Hand hole at each end of each tube

4 Mudholes round base.

Double riveted

Circular Seams Single riveted $\frac{13}{16}$ Rivets 2" Pitch
Vertical double $\frac{13}{16}$ R^8

THE SUDRON & CO L^D
IMPERIAL BOILER WORKS
STOCKTON-ON-TEES.