

## Lloyd's Register of British and Foreign Shipping.

(Report on Vessel No. 9000)Port **WEST HARTLEPOOL.**No. 2736 a.SHIP FORGINGS OR CASTINGS.

I have to report that the undermentioned Iron or Steel Forgings or Castings, manufactured by The Sunderland Forge Co. of Pallion for the Vessel No. 210, being built by Messrs. Furness Withy & Co. of Newcastle have been inspected by me as set forth below, and found to be, so far as can be seen, sound.


Mark on Forgings.

Lloyd's

No. 2736 a  
No. 6.Hugh CameronSunderland9-6-94

	STERN FRAME.	RUDDER FRAME.	STEM.
Material* ...	<u>Scrap iron</u>	<u>Scrap iron</u>	<u>Scrap iron</u>
How made ...	<u>Forged</u>	<u>Forged</u>	<u>Forged</u>
Dimensions ...	<u>10' x 6'</u>	<u>8' - 4"</u>	<u>10' x 2 3/4"</u>
Progress on Inspection	<u>Forged &amp; smithed</u>	<u>Forged &amp; smithed</u>	<u>Forged</u>
Date when Inspected	<u>July 12<sup>th</sup> to March 29/94</u>	<u>April 7<sup>th</sup> to May 26/94</u>	<u>March 29/94</u>

SKETCHES OF FRAMES SHOWING POSITION AND DESCRIPTION OF WELDS OF FORGINGS, OR PARTICULARS OF TESTS APPLIED TO CASTINGS.

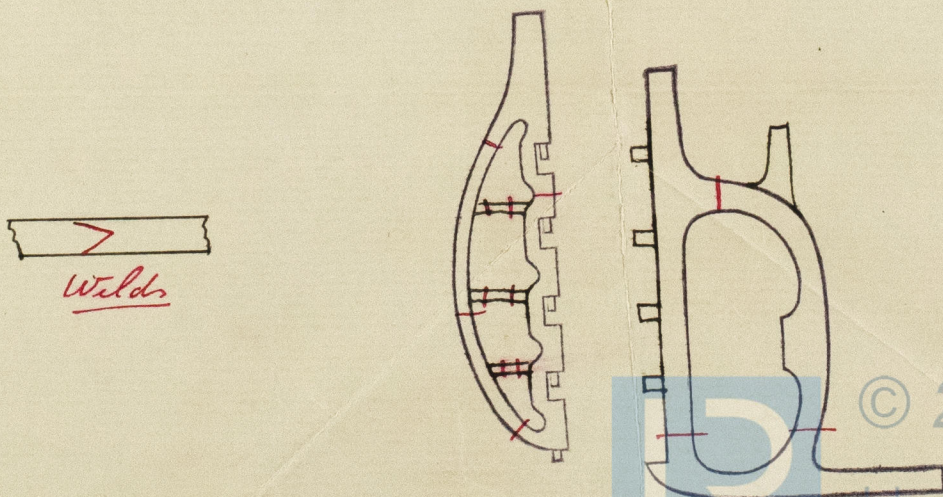

\* If of Iron, state whether scrap or puddled Iron.