


# MIDSHIP SECTION.

SCALE 1/4" = 1 FOOT

31.7.94  
27.9.94

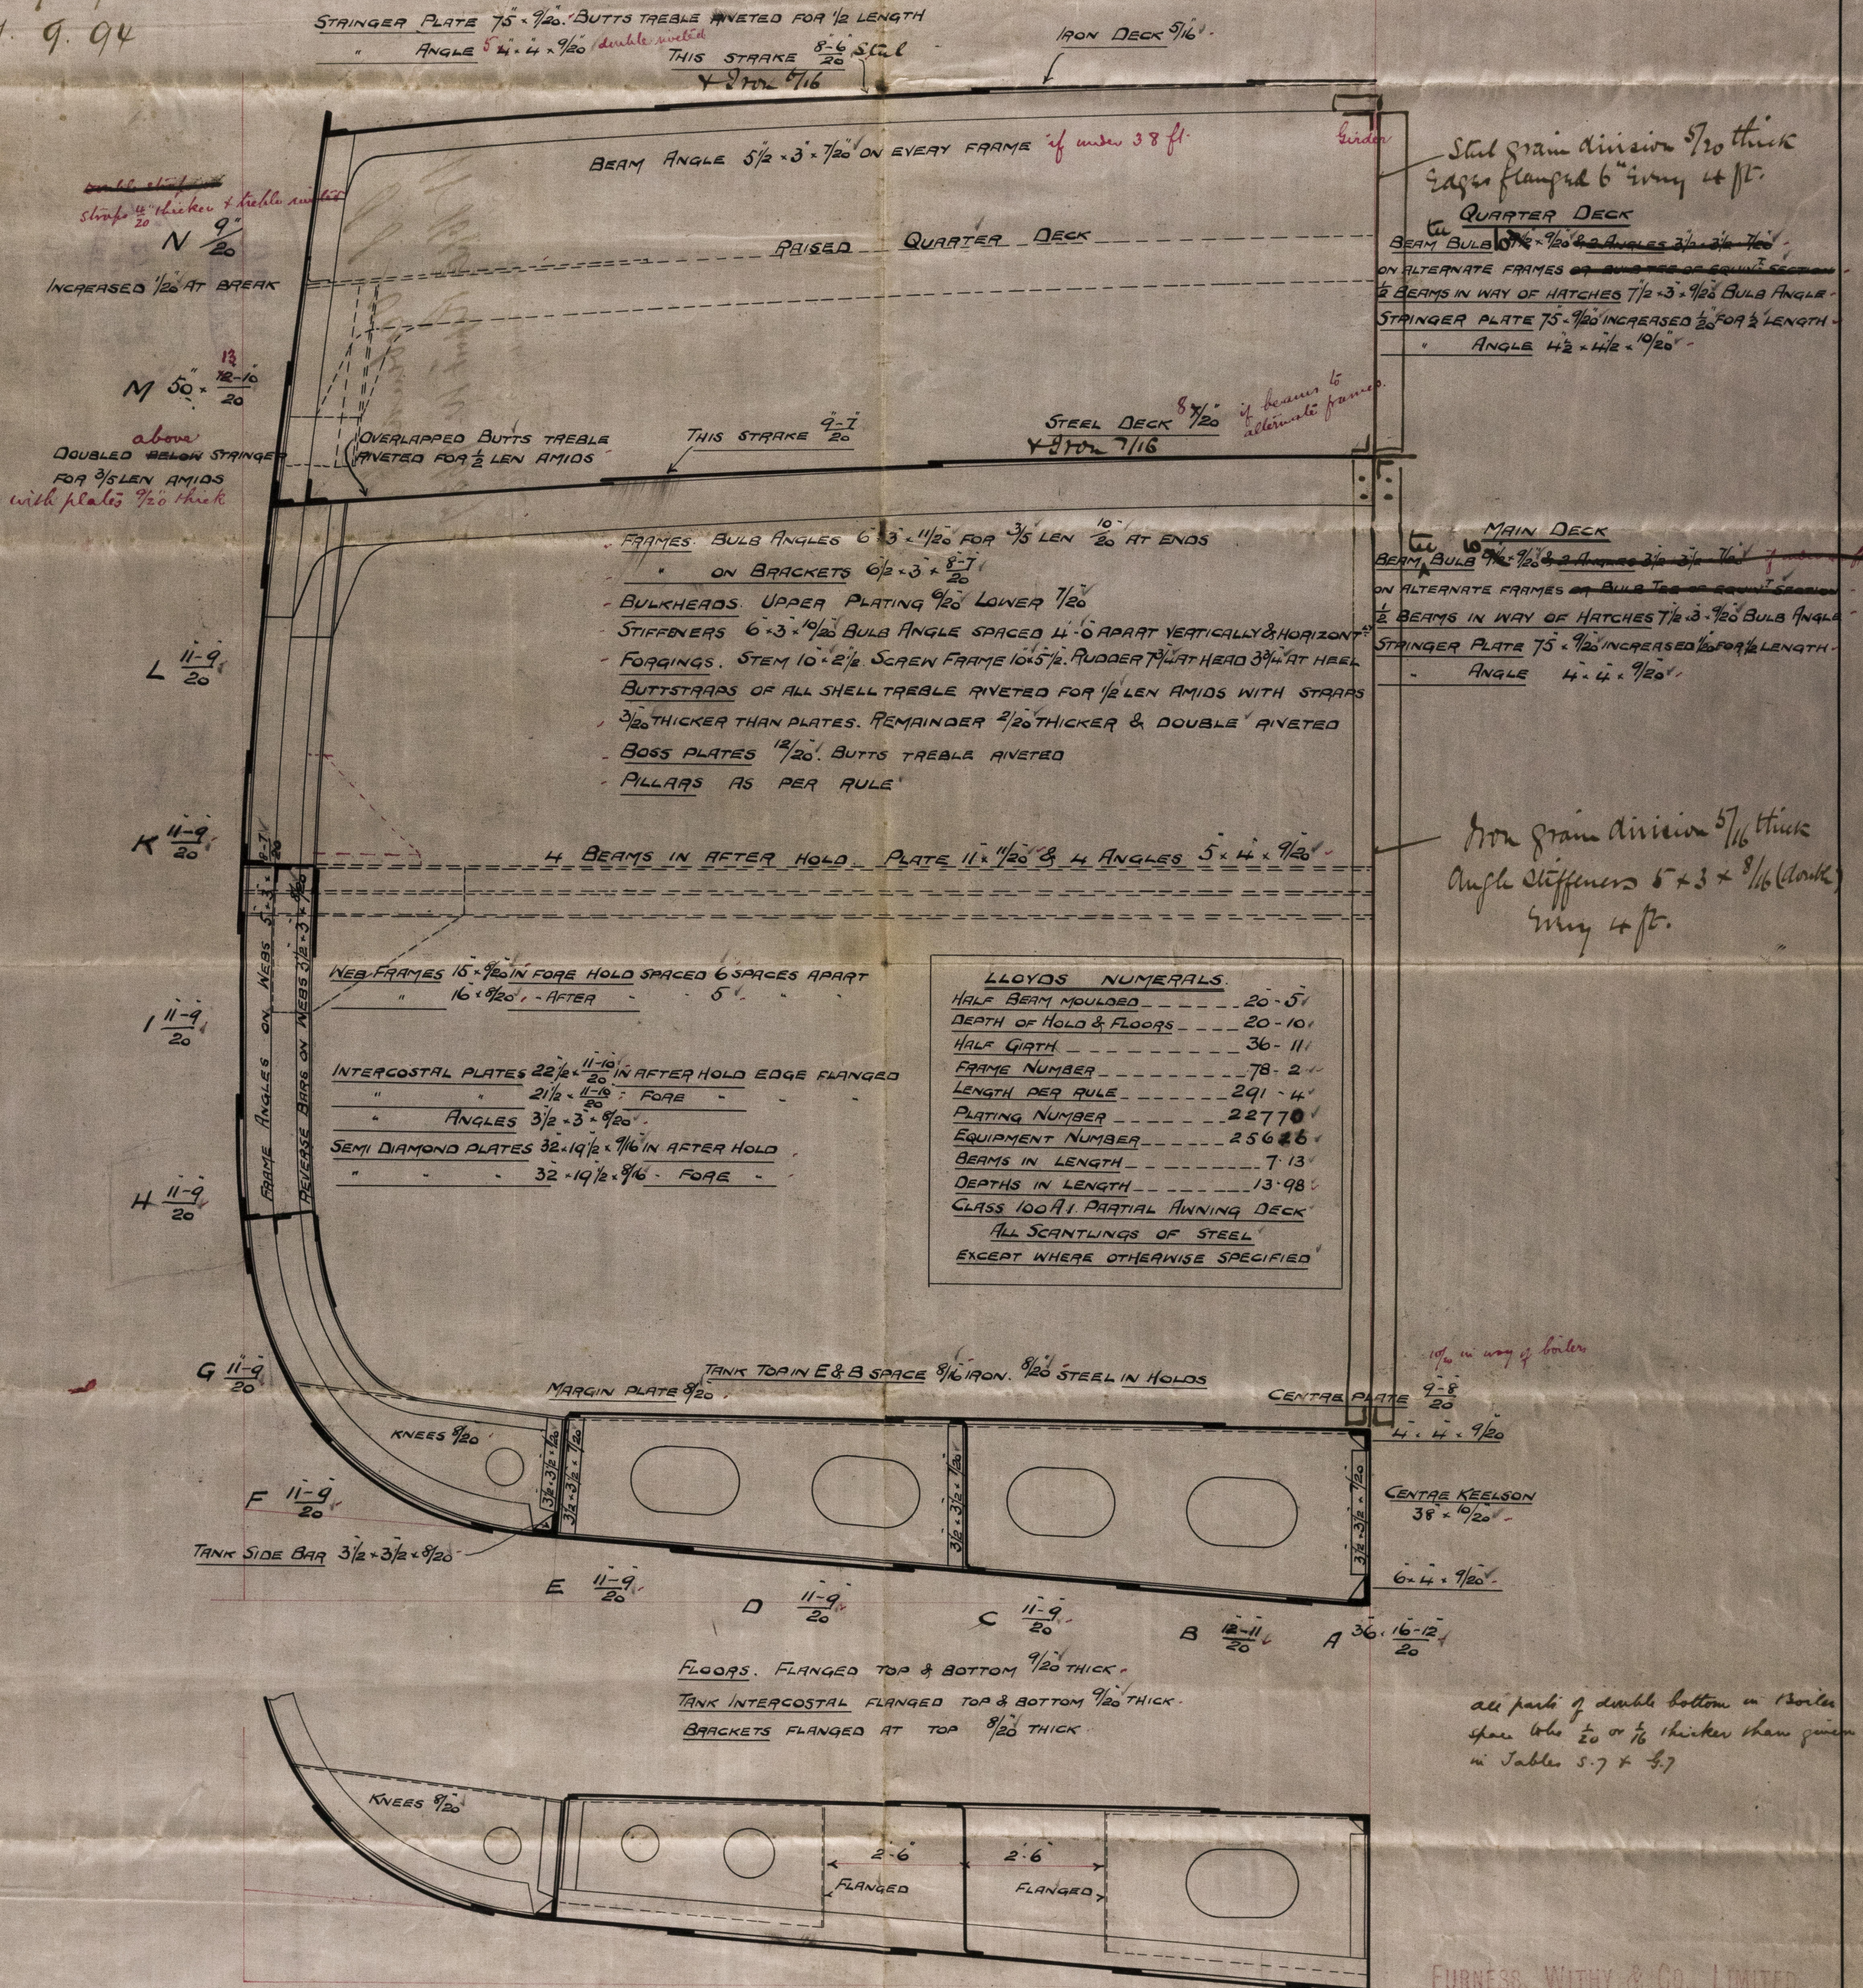

Nº 213.

307/764

FURNESS, WITBY & CO., LIMITED.  
SHIPBUILDERS & REPAIRERS.  
WEST HARTLEPOOL.  
TANCING No 12194  
JULY 10, 1894.




© 2020

Lloyd's Register  
Foundation



Furness Worthy & Co.  
No. 213.

Midship Section.

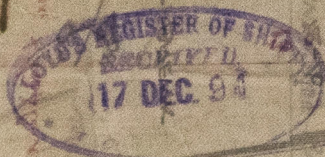

*with papers to ship  
for 9/10/94  
CONVERTED FROM 21/10/94  
open*

*S.S. "Verbena"  
W. Hope. Report W. 9637.  
Do First Entry Do 9963.*

HPL 3075-0001



© 2020

Lloyd's Register  
Foundation