




STEEL BOILER

SCALE 1" = 1 FOOT

W.P. = 80 LBS

Messrs. Furness, Withy & Co. Ltd.
Order No. 835.

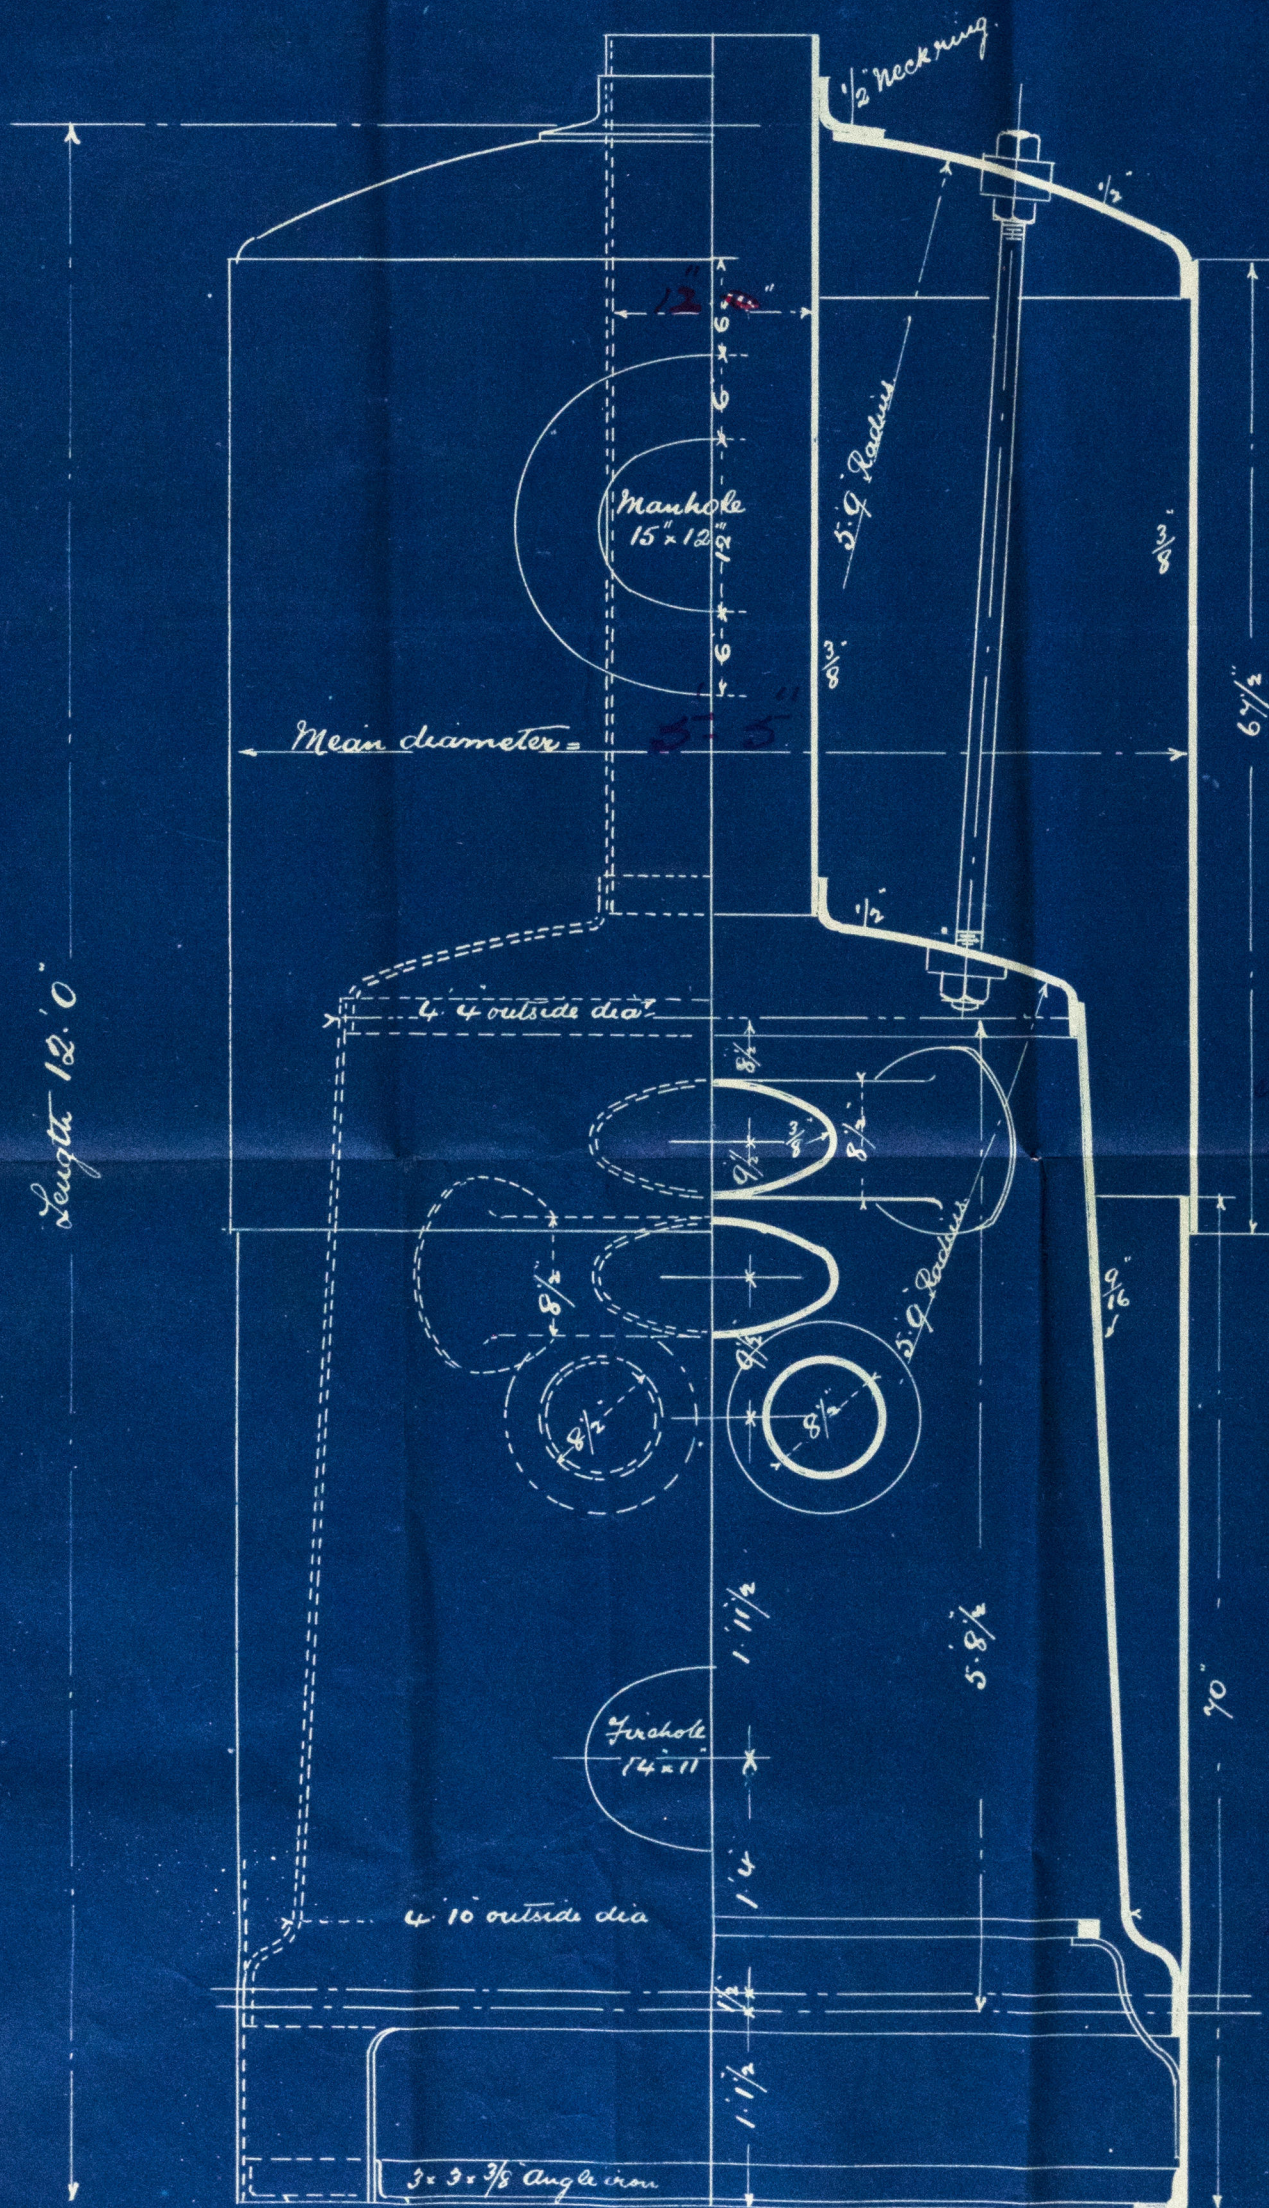

Circular Seams Single riveted 13/16 rivets 2" pitch
Vertical ——— double ——— 13/16 ——— 2 3/4 ———

1/10/94.

THOS SUDRON & CO. LTD.
IMPERIAL BOILER WORKS
STOCKTON-ON-TEES

Furness Mitty 167
N° 213 Vessel

8000⁰ pressure

S.S. "Verbena",
W. Hpl. Report N° 9663.

HPL 375-0002



© 2020

Lloyd's Register
Foundation