

## Lloyd's Register of British and Foreign Shipping.

*West Hartlepool*(Report on Vessel No. *9663*)Port **WEST HARTLEPOOL.**

## No. 2864-a. SHIP FORGINGS OR CASTINGS.

I have to report that the undermentioned Iron ~~or Steel~~ Forgings ~~or Castings~~,  
manufactured by *Messrs. R. Gray & Co.*

of *Warrington* for the Vessel No. *213*, being built

by *Messrs. Furness Brothers & Co.* of *Warrington*

have been inspected by me as set forth below, and found to be, so far as can be seen,  
*sound.*

Mark on Forgings.

Lloyd's

No. 2864-a



No. 6.

*Hugh Cameron**Sunderland.*

12-12-94

	STERN FRAME.	RUDDER FRAME.	STEM.
Material* ...	<i>Scrap iron</i>	<i>Scrap iron</i>	<i>Scrap iron</i>
How made ...	<i>Forged</i>	<i>Forged</i>	<i>Forged</i>
Dimensions ...	<i>10' x 5 1/2'</i>	<i>7 3/4' - 3 3/4'</i>	<i>10' x 2 1/2'</i>
Progress on Inspection	<i>Forged &amp; Smoothed</i>	<i>Forged &amp; Smoothed</i>	<i>Forged</i>
Date when Inspected	<i>Aug 13<sup>th</sup> to Oct 9/94</i>	<i>Oct 18<sup>th</sup> to Dec 5/94</i>	<i>Oct 9/94</i>

SKETCHES OF FRAMES SHOWING POSITION AND DESCRIPTION OF WELDS OF FORGINGS, OR PARTICULARS OF TESTS APPLIED TO CASTINGS.

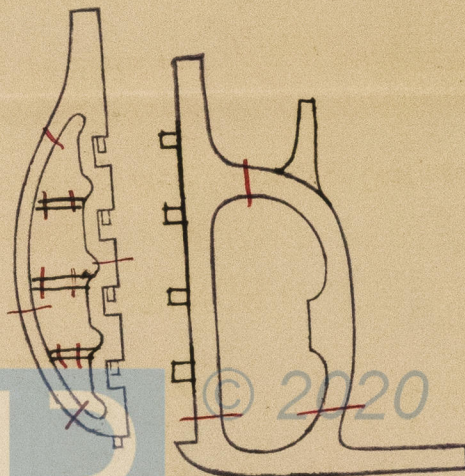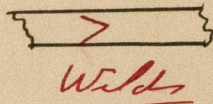

Fee (if any chargeable) £

To be paid at

\* If of Iron, state whether scrap or puddled Iron. HPL 375-0003