


PROFILE

SCALE 1/8" = 1 FOOT

BULB ANGLE FRAMES IN ONE LENGTH FROM TANK SIDE TO BRIDGE DECK

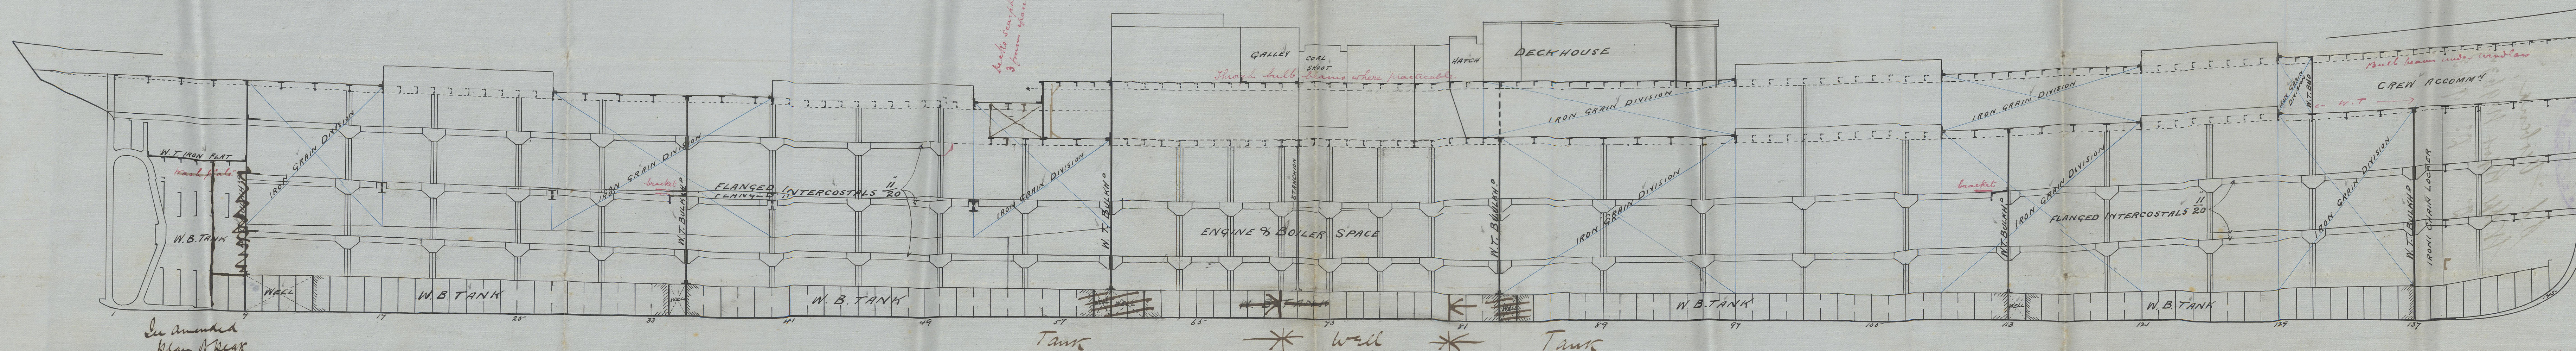

N^o 213

47/1
30/7/94

FURNESS, WITBY & CO., LIMITED.
SHIPBUILDERS & REPAIRERS.
WEST HARTLEPOOL

© 2020
July 9th 1894.
Lloyd's Register
Foundation

Profile

LOYALTY
27 SEP 94
LONDON

S.S. Verbena,
W. H. L. Report No. 9637
D. D. 9663

HPL 375-001

© 2020

Lloyd's Register
Foundation