

846.


SKETCH of IRON LOWERMASTS

for Messrs Furness Withy & Co. N^o 213 S/S.



Scale $\frac{1}{4}$ " = one foot.

Masts made in two plates in the round. Seams single riveted.
 Butts below deck double riveted: above deck double riveted: $\frac{1}{16}$ " thicker than plates they connect.
 Rivets, spaced 5 diameters apart.
Masts to carry fore & aft sail only.

Foremast.

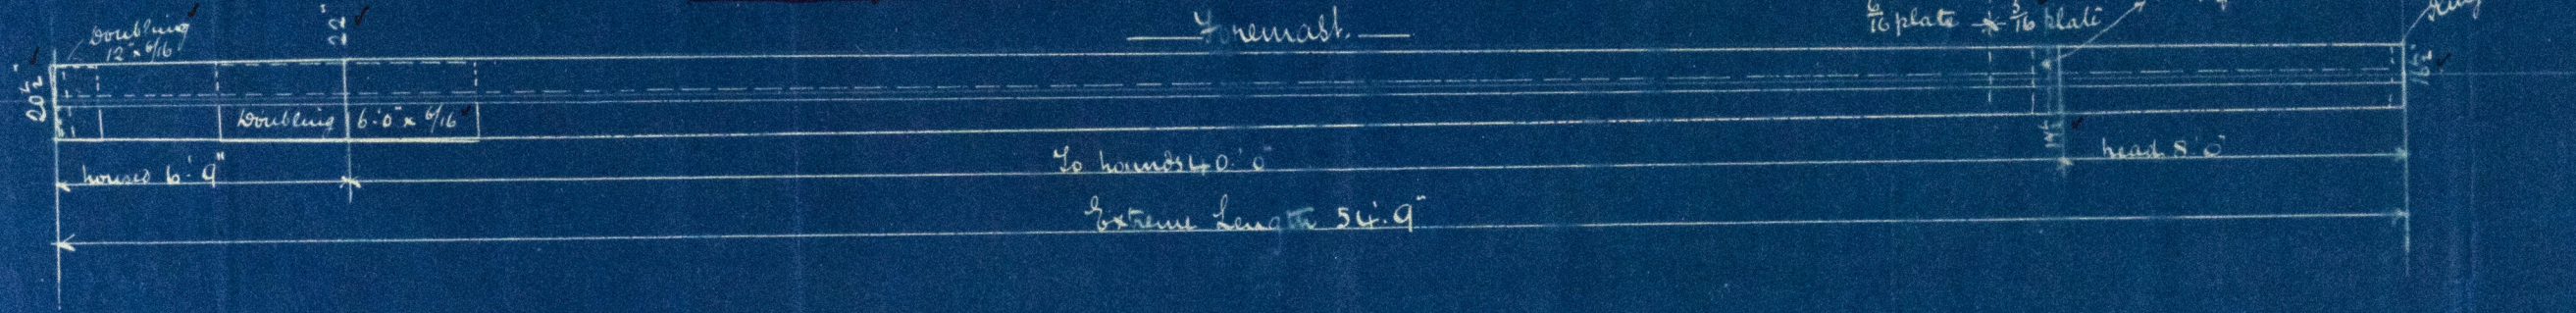

Mainmast.

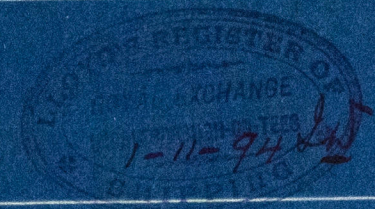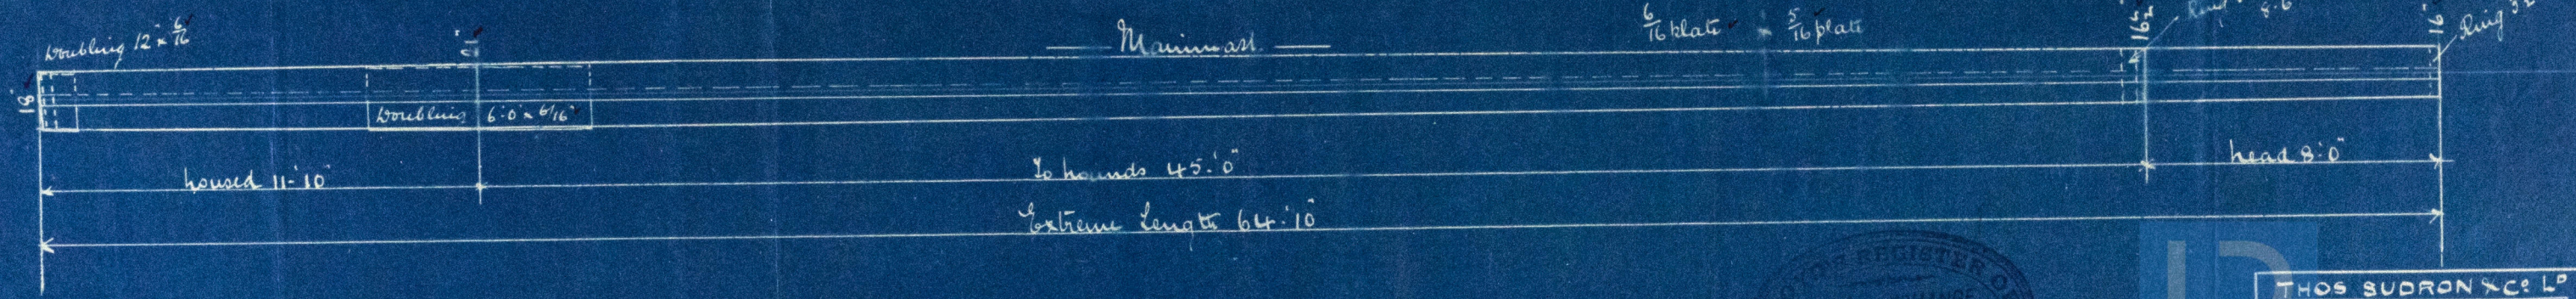

THOS SUDRON & CO. LD
 MAKERS
 STOCKTON ON TEES

East-Plan
Furness Withy & Co.
No 213.

S. J. Verbeke,
W. Hpl. Report No. 9663.

HPL 375-0014



© 2020

Lloyd's Register
Foundation