


# MIDSHIP SECTION.

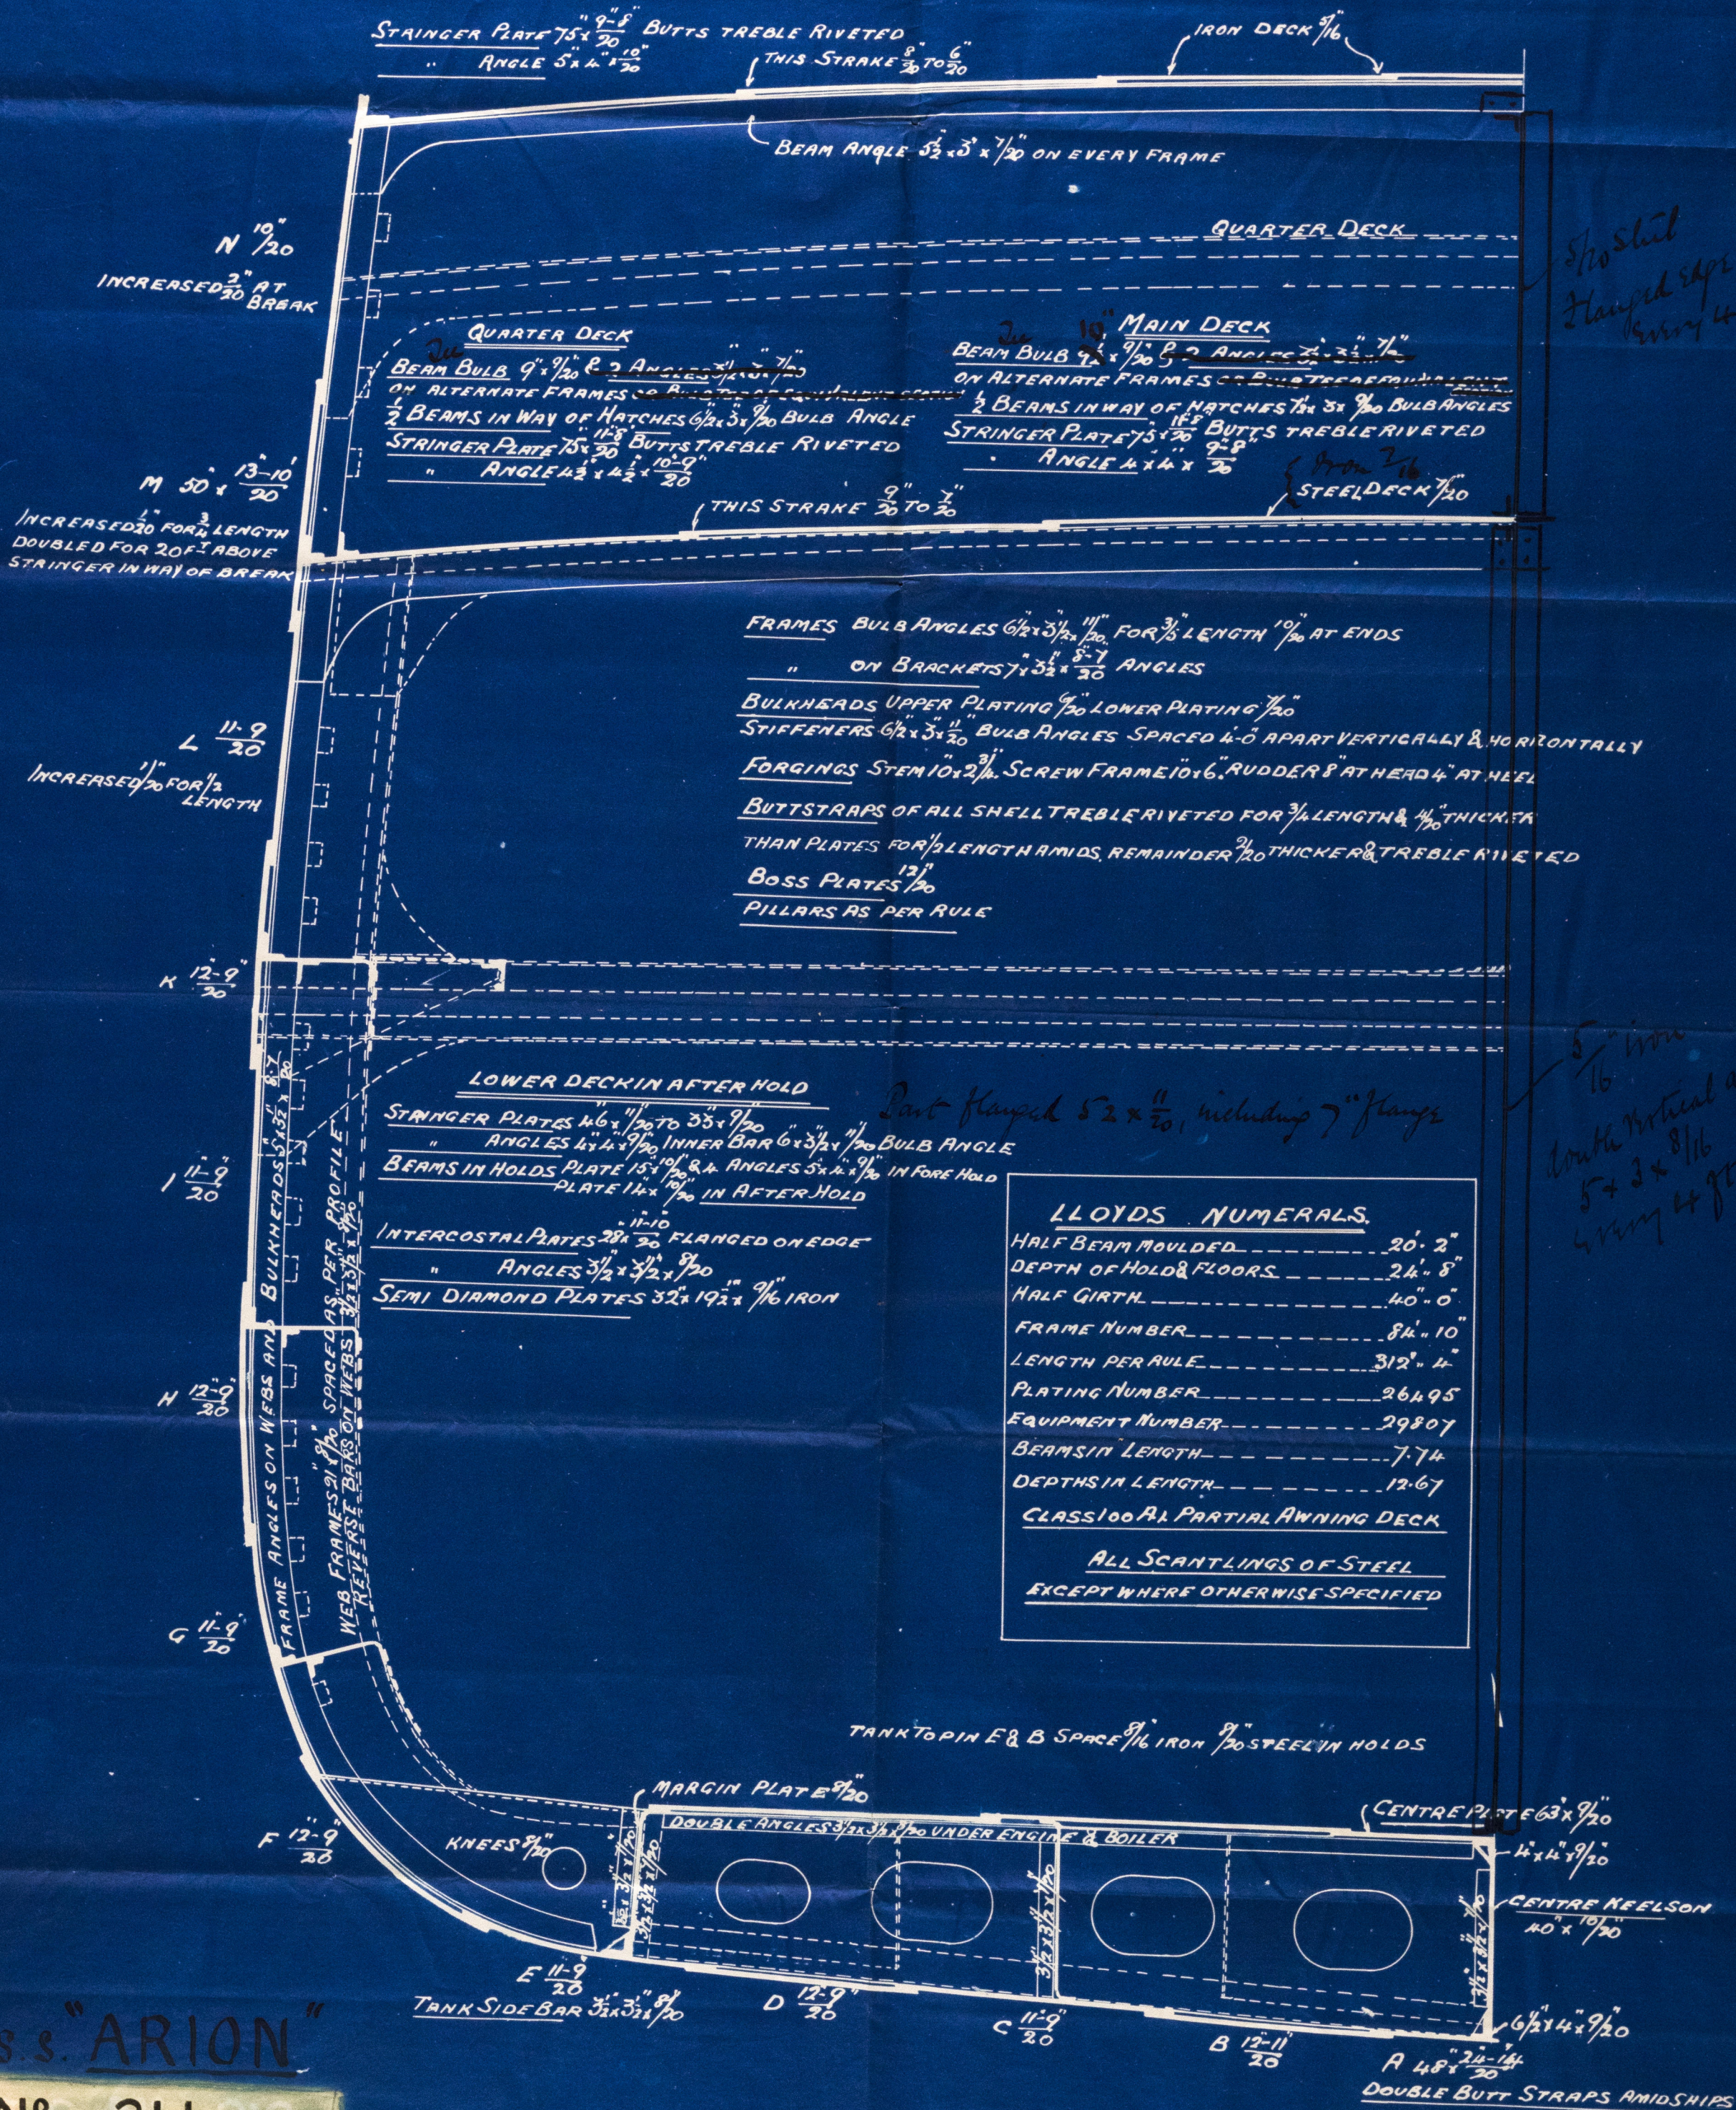

S.S. "ARION"  
 No. 211.12.





Furness Withy & Co.  
No. 211

Master's Certificate

S.S. "Arion"

W. Hpl. 1<sup>st</sup> Entry Rpt No.

9685.

HPL 375-0026



© 2020

Lloyd's Register  
Foundation