

S. S. Aron

Received at **WEST HARTLEPOOL** Office, 11th June 1894

Lloyd's Register of British and Foreign Shipping.

(Report on Vessel No. 9685 Port WEST HARTLEPOOL.)

W. Pool

No. 2749a.

SHIP FORGINGS OR CASTINGS.

The words FORGINGS or CASTINGS, IRON or STEEL, should be struck out as may be required.

I have to report that the undermentioned Iron ~~or Steel~~ Forgings ~~or Castings~~, manufactured by *Messrs J Richardson Sons* of *Warrington* for the Vessel No. 211, being built by *Messrs Furness Brothers Co.* of *Warrington* have been inspected by me as set forth below, and found to be, so far as can be seen, *sound.*

Mark on Forgings.

Lloyd's


No. 2749a
W.C.

Ralph Cameron

Sunderland.
9-6-94

	STERN FRAME.	RUDDER FRAME.	STEM.
Material* ...	<i>Scrap iron</i>	<i>Scrap iron</i>	<i>Scrap iron</i>
How made ...	<i>Forged</i>	<i>Forged</i>	<i>Forged</i>
Dimensions ...	<i>10' x 6'</i>	<i>8' - 4'</i>	<i>10" x 2 3/4"</i>
Progress on Inspection	<i>Forged & smithed</i>	<i>Forged & smithed</i>	<i>Forged</i>
Date when Inspected	<i>July 26th to April 10/94</i>	<i>April 19th to May 31/94</i>	<i>April 10/94</i>

SKETCHES OF FRAMES SHOWING POSITION AND DESCRIPTION OF WELDS OF FORGINGS, OR PARTICULARS OF TESTS APPLIED TO CASTINGS.

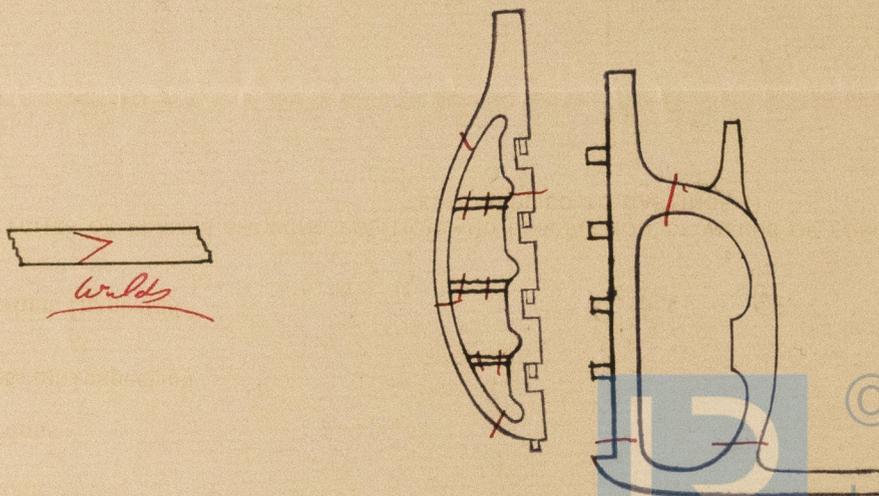

© 2019
Lloyd's Register
Foundation

* If of Iron, state whether scrap or puddled Iron.