

Lloyd's Register of British and Foreign Shipping.

(Report on Vessel No. 9728 Port **WEST HARTLEPOOL**)No. 2917. a. SHIP FORGINGS OR CASTINGS.

I have to report that the undermentioned Iron or Steel Forgings or Castings, manufactured by Messrs J Richardson & Sons of Warrington for the Vessel No. 215, being built by Messrs Furness Withy & Co. of Warrington have been inspected by me as set forth below, and found to be, so far as can be seen, sound


Mark on Forgings.

Lloyd's

No. 2917 a
W.C.Messrs CameronLondon9.5.95
STEM.

	STERN FRAME.	RUDDER FRAME.	STEM.
Material*	<u>Scrap iron</u>	<u>Scrap iron</u>	<u>Scrap iron</u>
How made	<u>Forged</u>	<u>Forged</u>	<u>Forged</u>
Dimensions	<u>10 x 6</u>	<u>8 1/2 x 14 1/4</u>	<u>10 x 2 3/4</u>
Progress on Inspection	<u>Forged & smithed</u>	<u>Forged & smithed</u>	<u>Forged</u>
Date when Inspected	<u>Nov 21st to Dec 18/94</u>	<u>Feb 5th to April 17/95</u>	<u>Dec 18/94</u>

SKETCHES OF FRAMES SHOWING POSITION AND DESCRIPTION OF WELDS OF FORGINGS, OR PARTICULARS OF TESTS APPLIED TO CASTINGS.

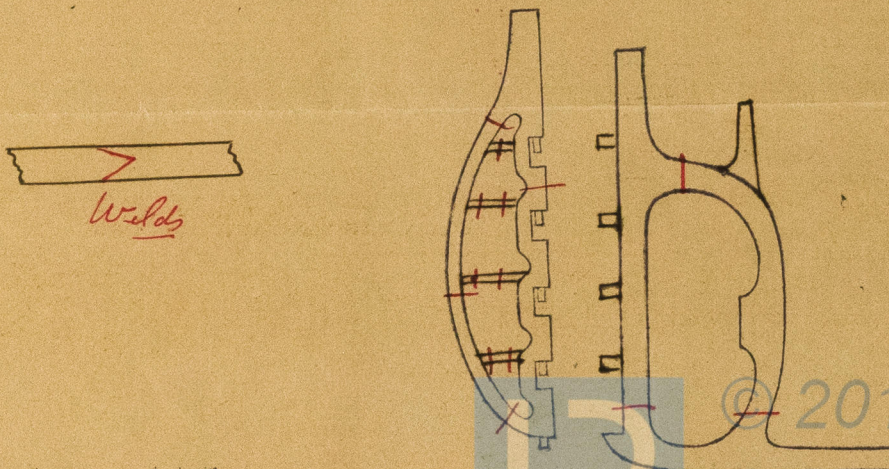

Fee (if any chargeable) £ : :

To be paid at