

No: 215


218 St. Paul's letter 10.12.94
216 7116 12.12.94
approved 30.12.94
Cancelled C.F.

22.11.94

S.S.N^o 215. *218*

FRAMES OF BULB ANGLE SECTION CARRIED UP IN ONE LENGTH FROM TANK SIDE TO SPAR DECK

FRAMES OF BULB ANGLE SECTION CARRIED UP IN ONE LENGTH FROM TANK SIDE TO BRIDGE DECK

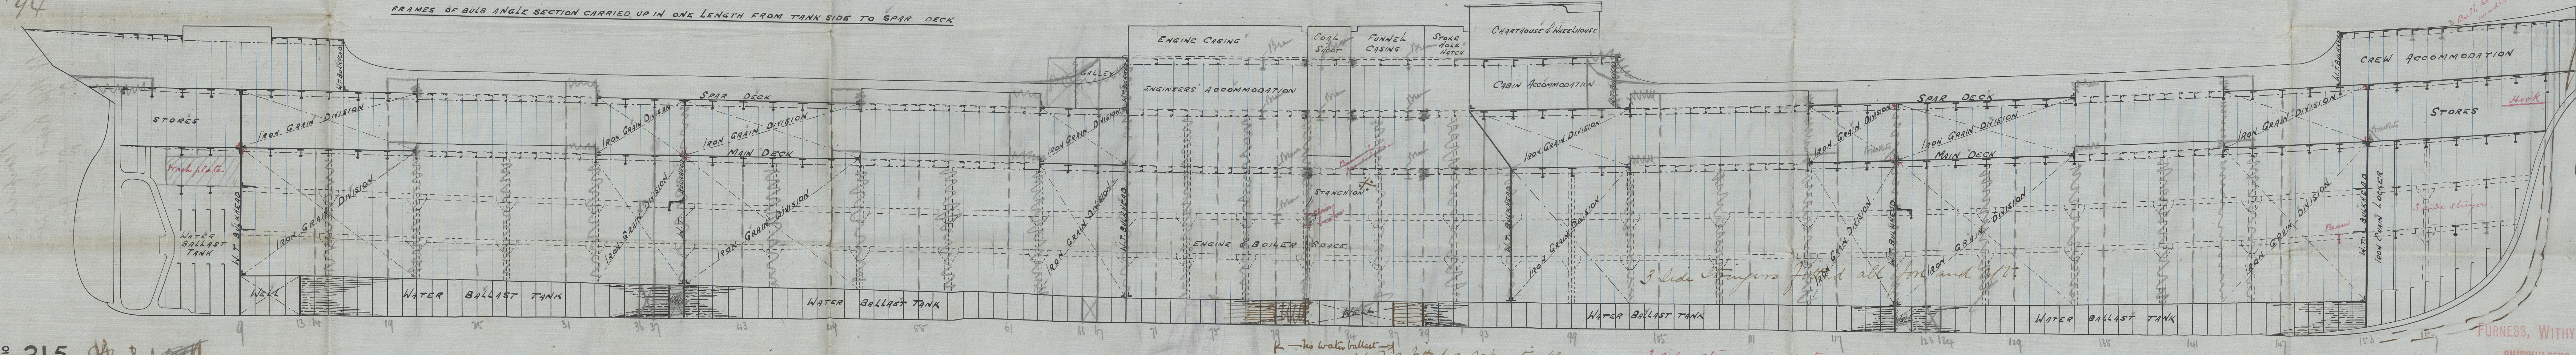

Scale $\frac{1}{8}$ " = 1 FOOT
** Not fitted, not practicable*

W. & H. Brans & Co. as amended in pencil.

J.H.L.
21/11/94

FURNESS, WITBY & CO., LIMITED.
SHIPBUILDERS & REPAIRERS.
WEST HARTLEPOOL.
Nov. 15th 1894

Allowed to
Shanghai Steam
C.F.

Turners Withy Ho.

No. 215 ~~218~~

Profile.

W. Hpl. Report No 9535.

S.S. "Newfield",

W. Hpl. Report No 9721

No. No. 9728

HPL 375-0096

LR

© 2020

Lloyd's Register
Foundation