
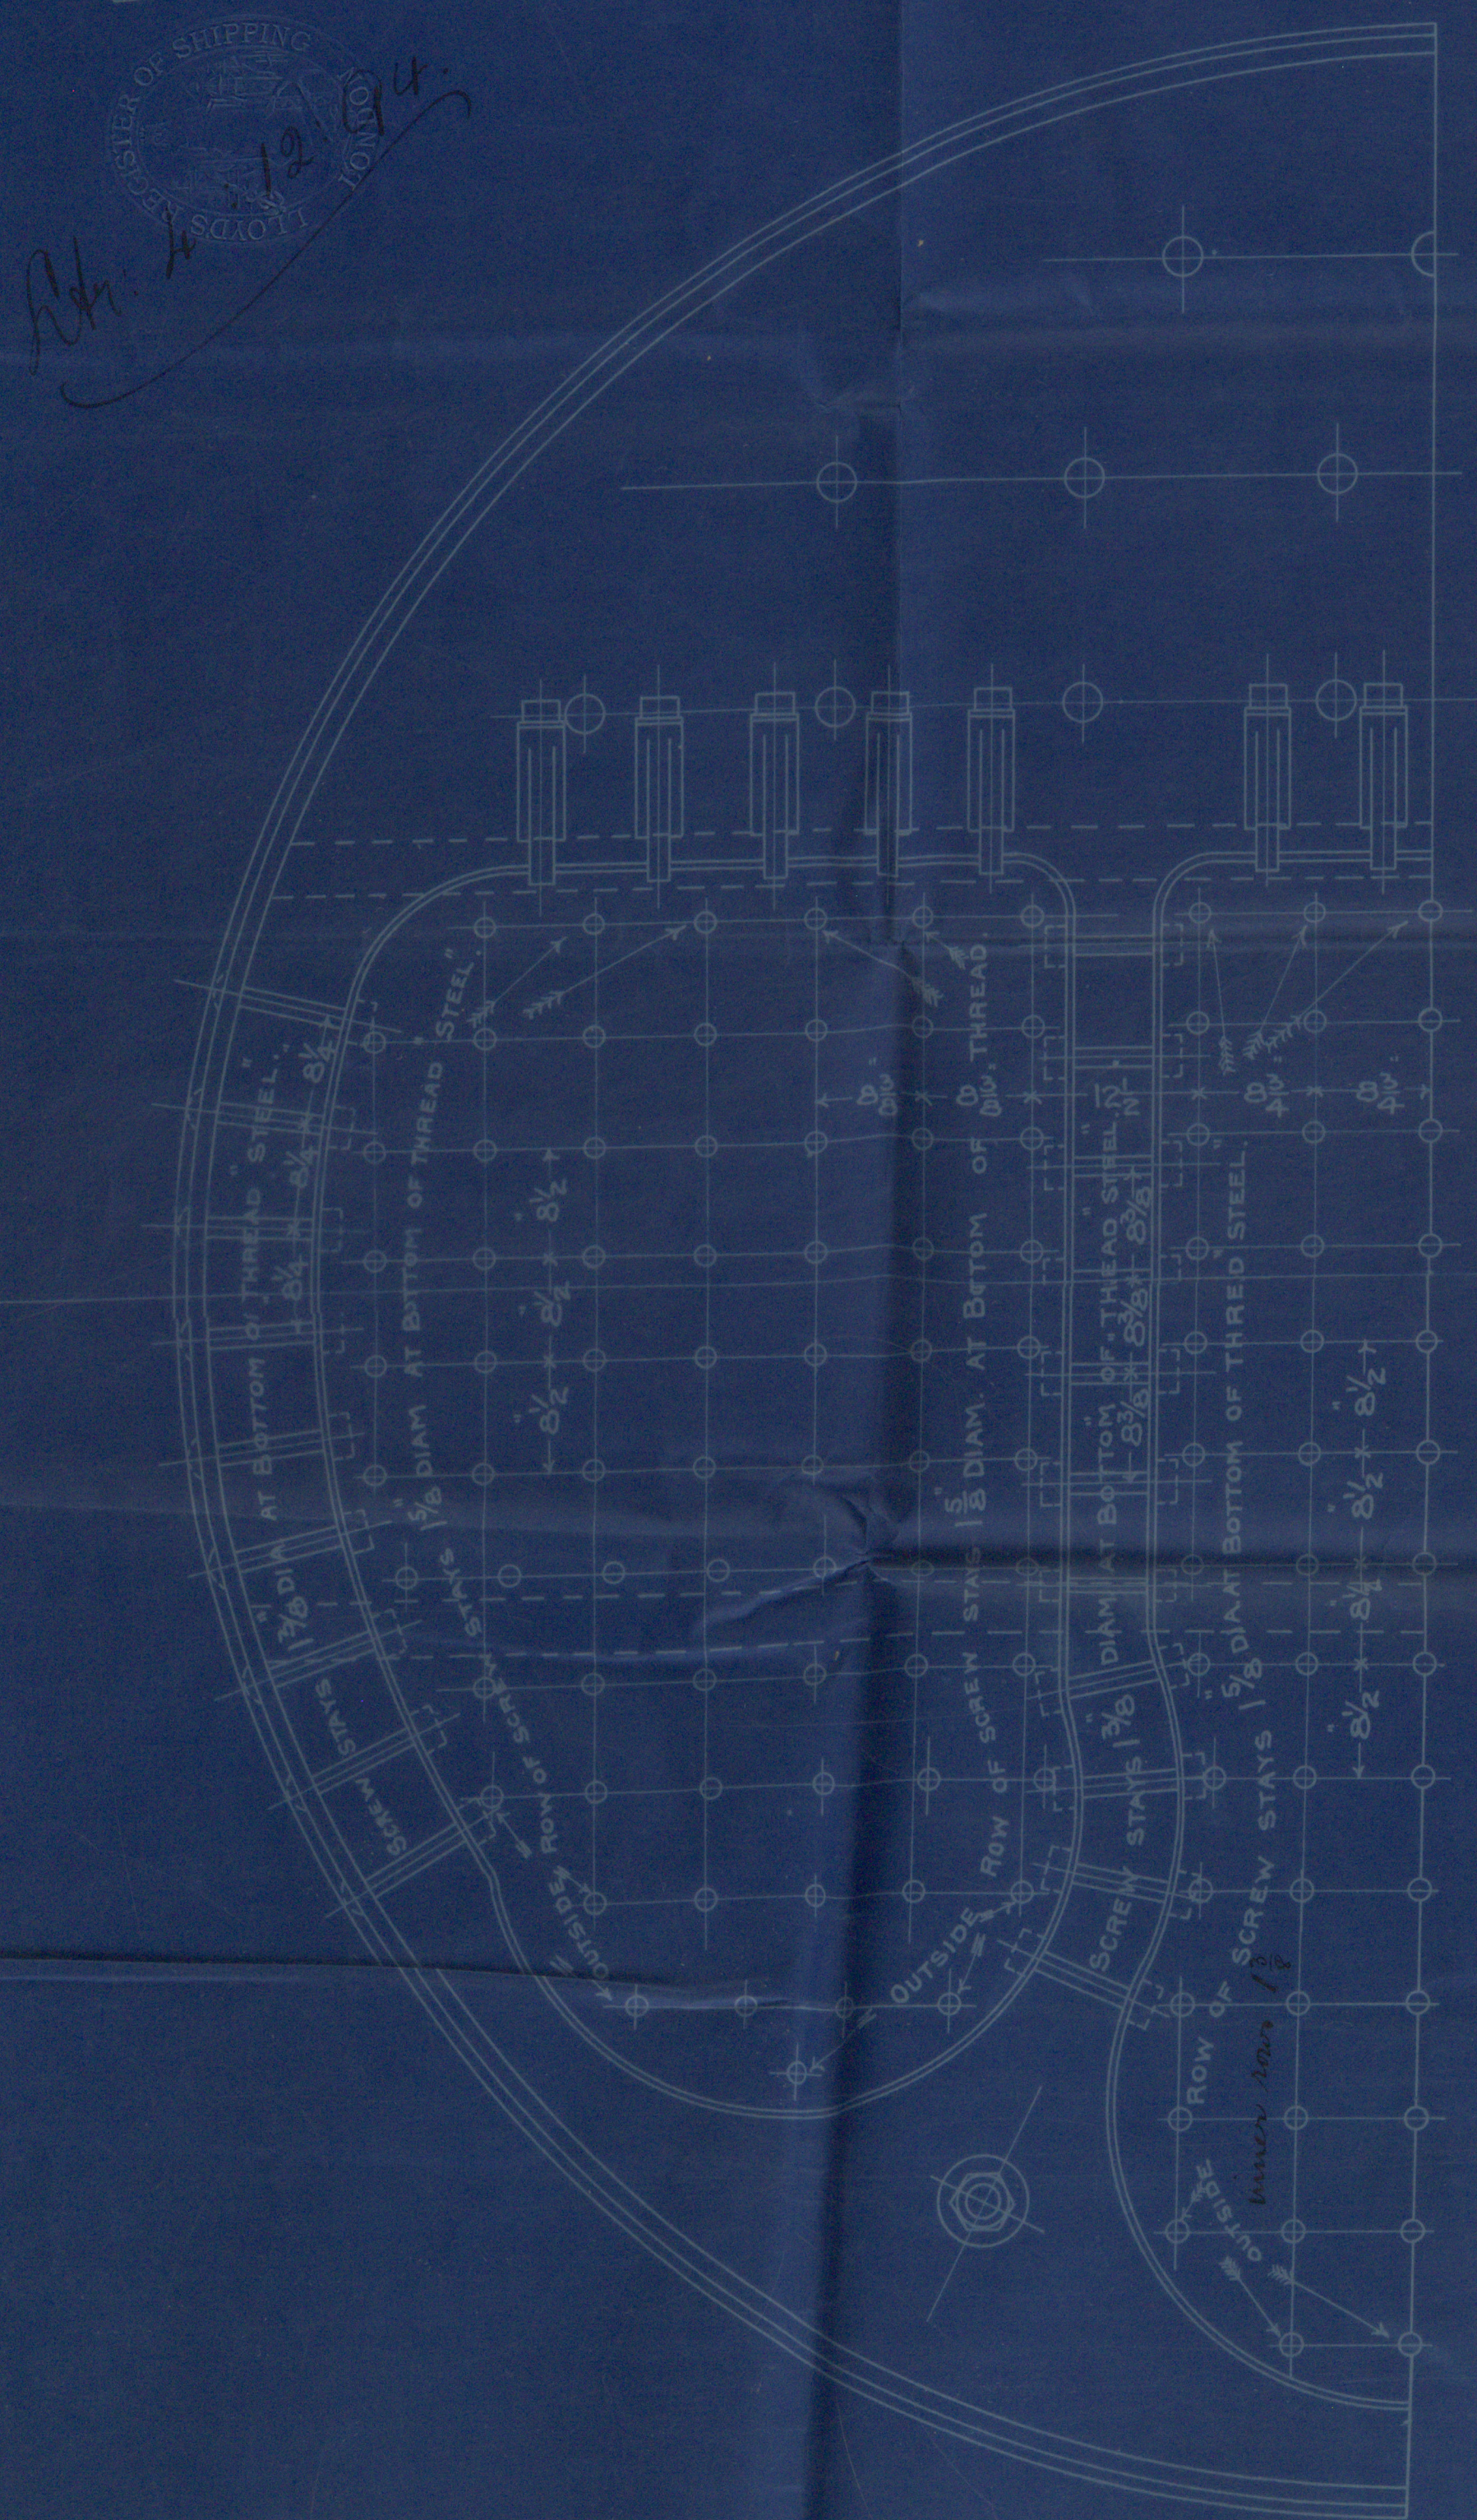


Mar 1. 12. 94

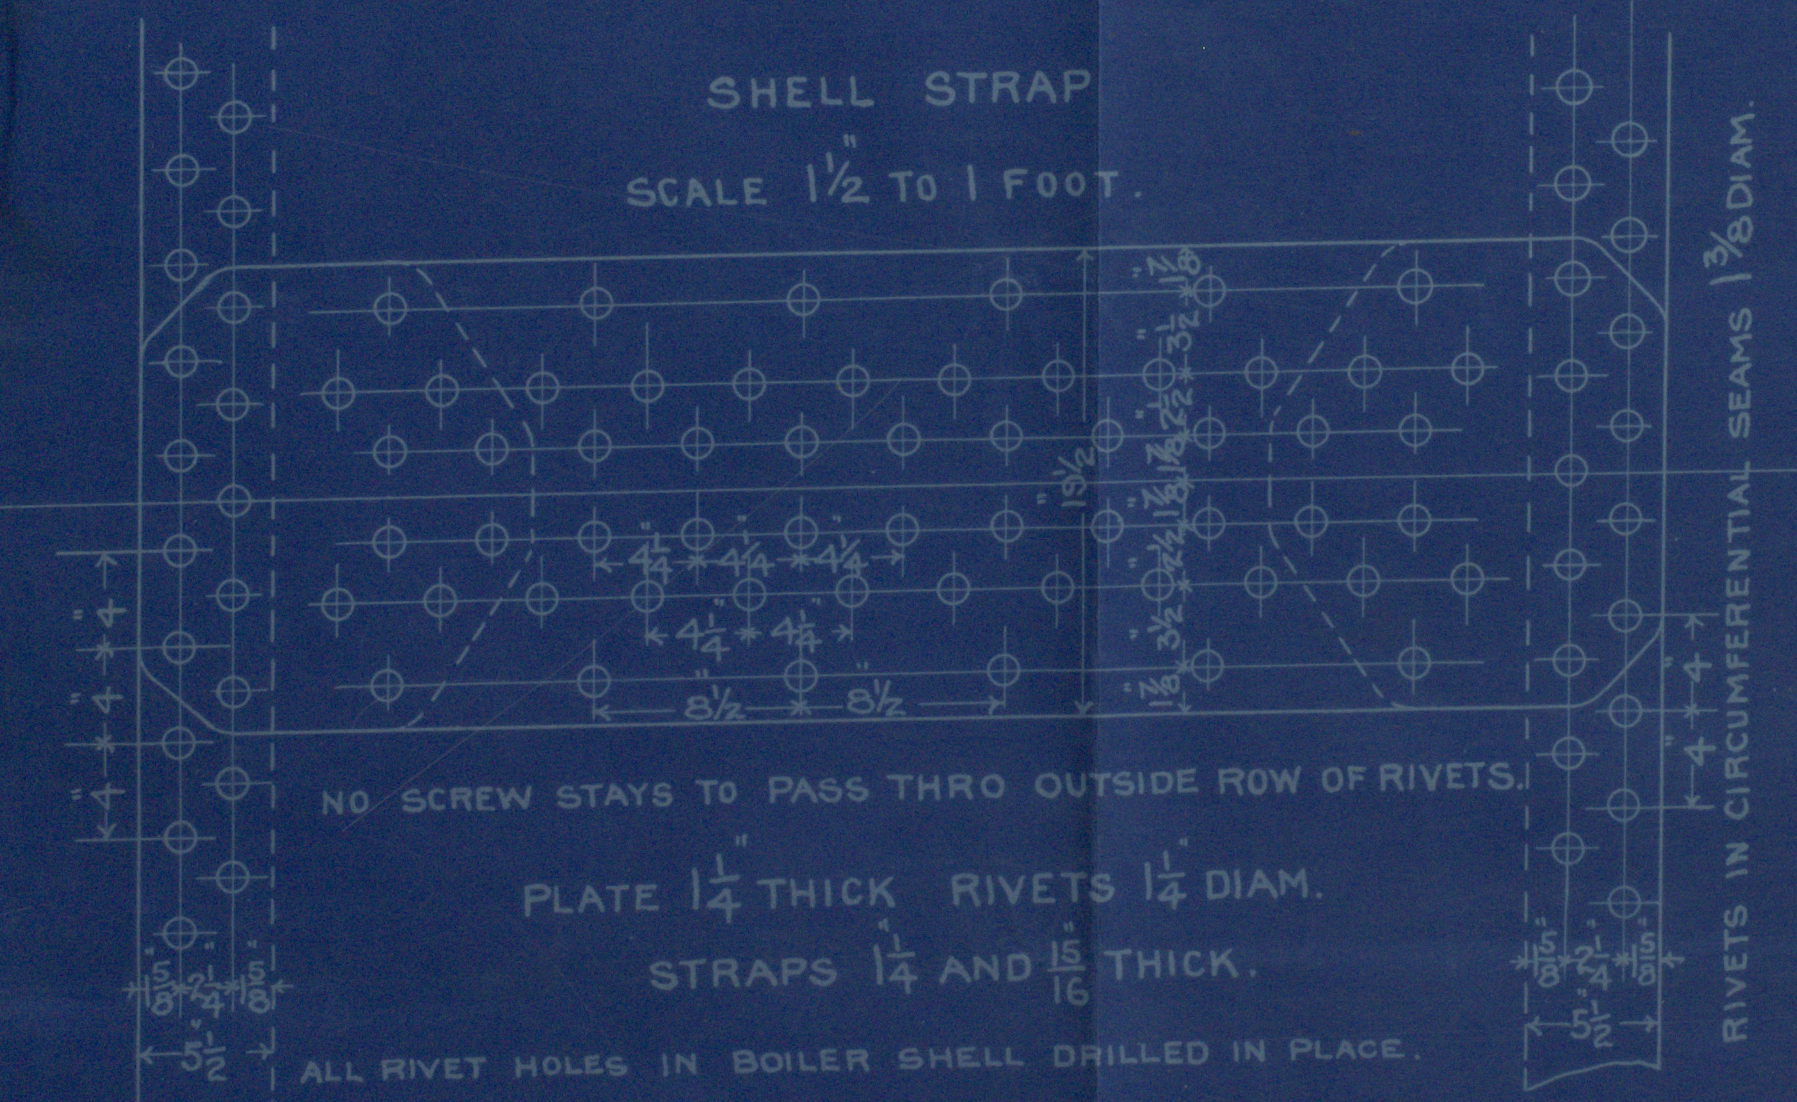



# BOILERS. NO 1014.

TO BE FITTED TO MESSRS FURNESS WITHY & CO S.S. N°

TO PASS "LLOYDS" FOR A WORKING PRESSURE OF 160 LBS PER SQ INCH.

SCALE 1"=1 FOOT.

No. of Drawing	3100
No. of Drawing	
Where Sent	Lloyds Surveyors
Examined by	H. J. Kensington
Date	3-29-94
THOMAS LLOYD & CO. LTD. LONDON	

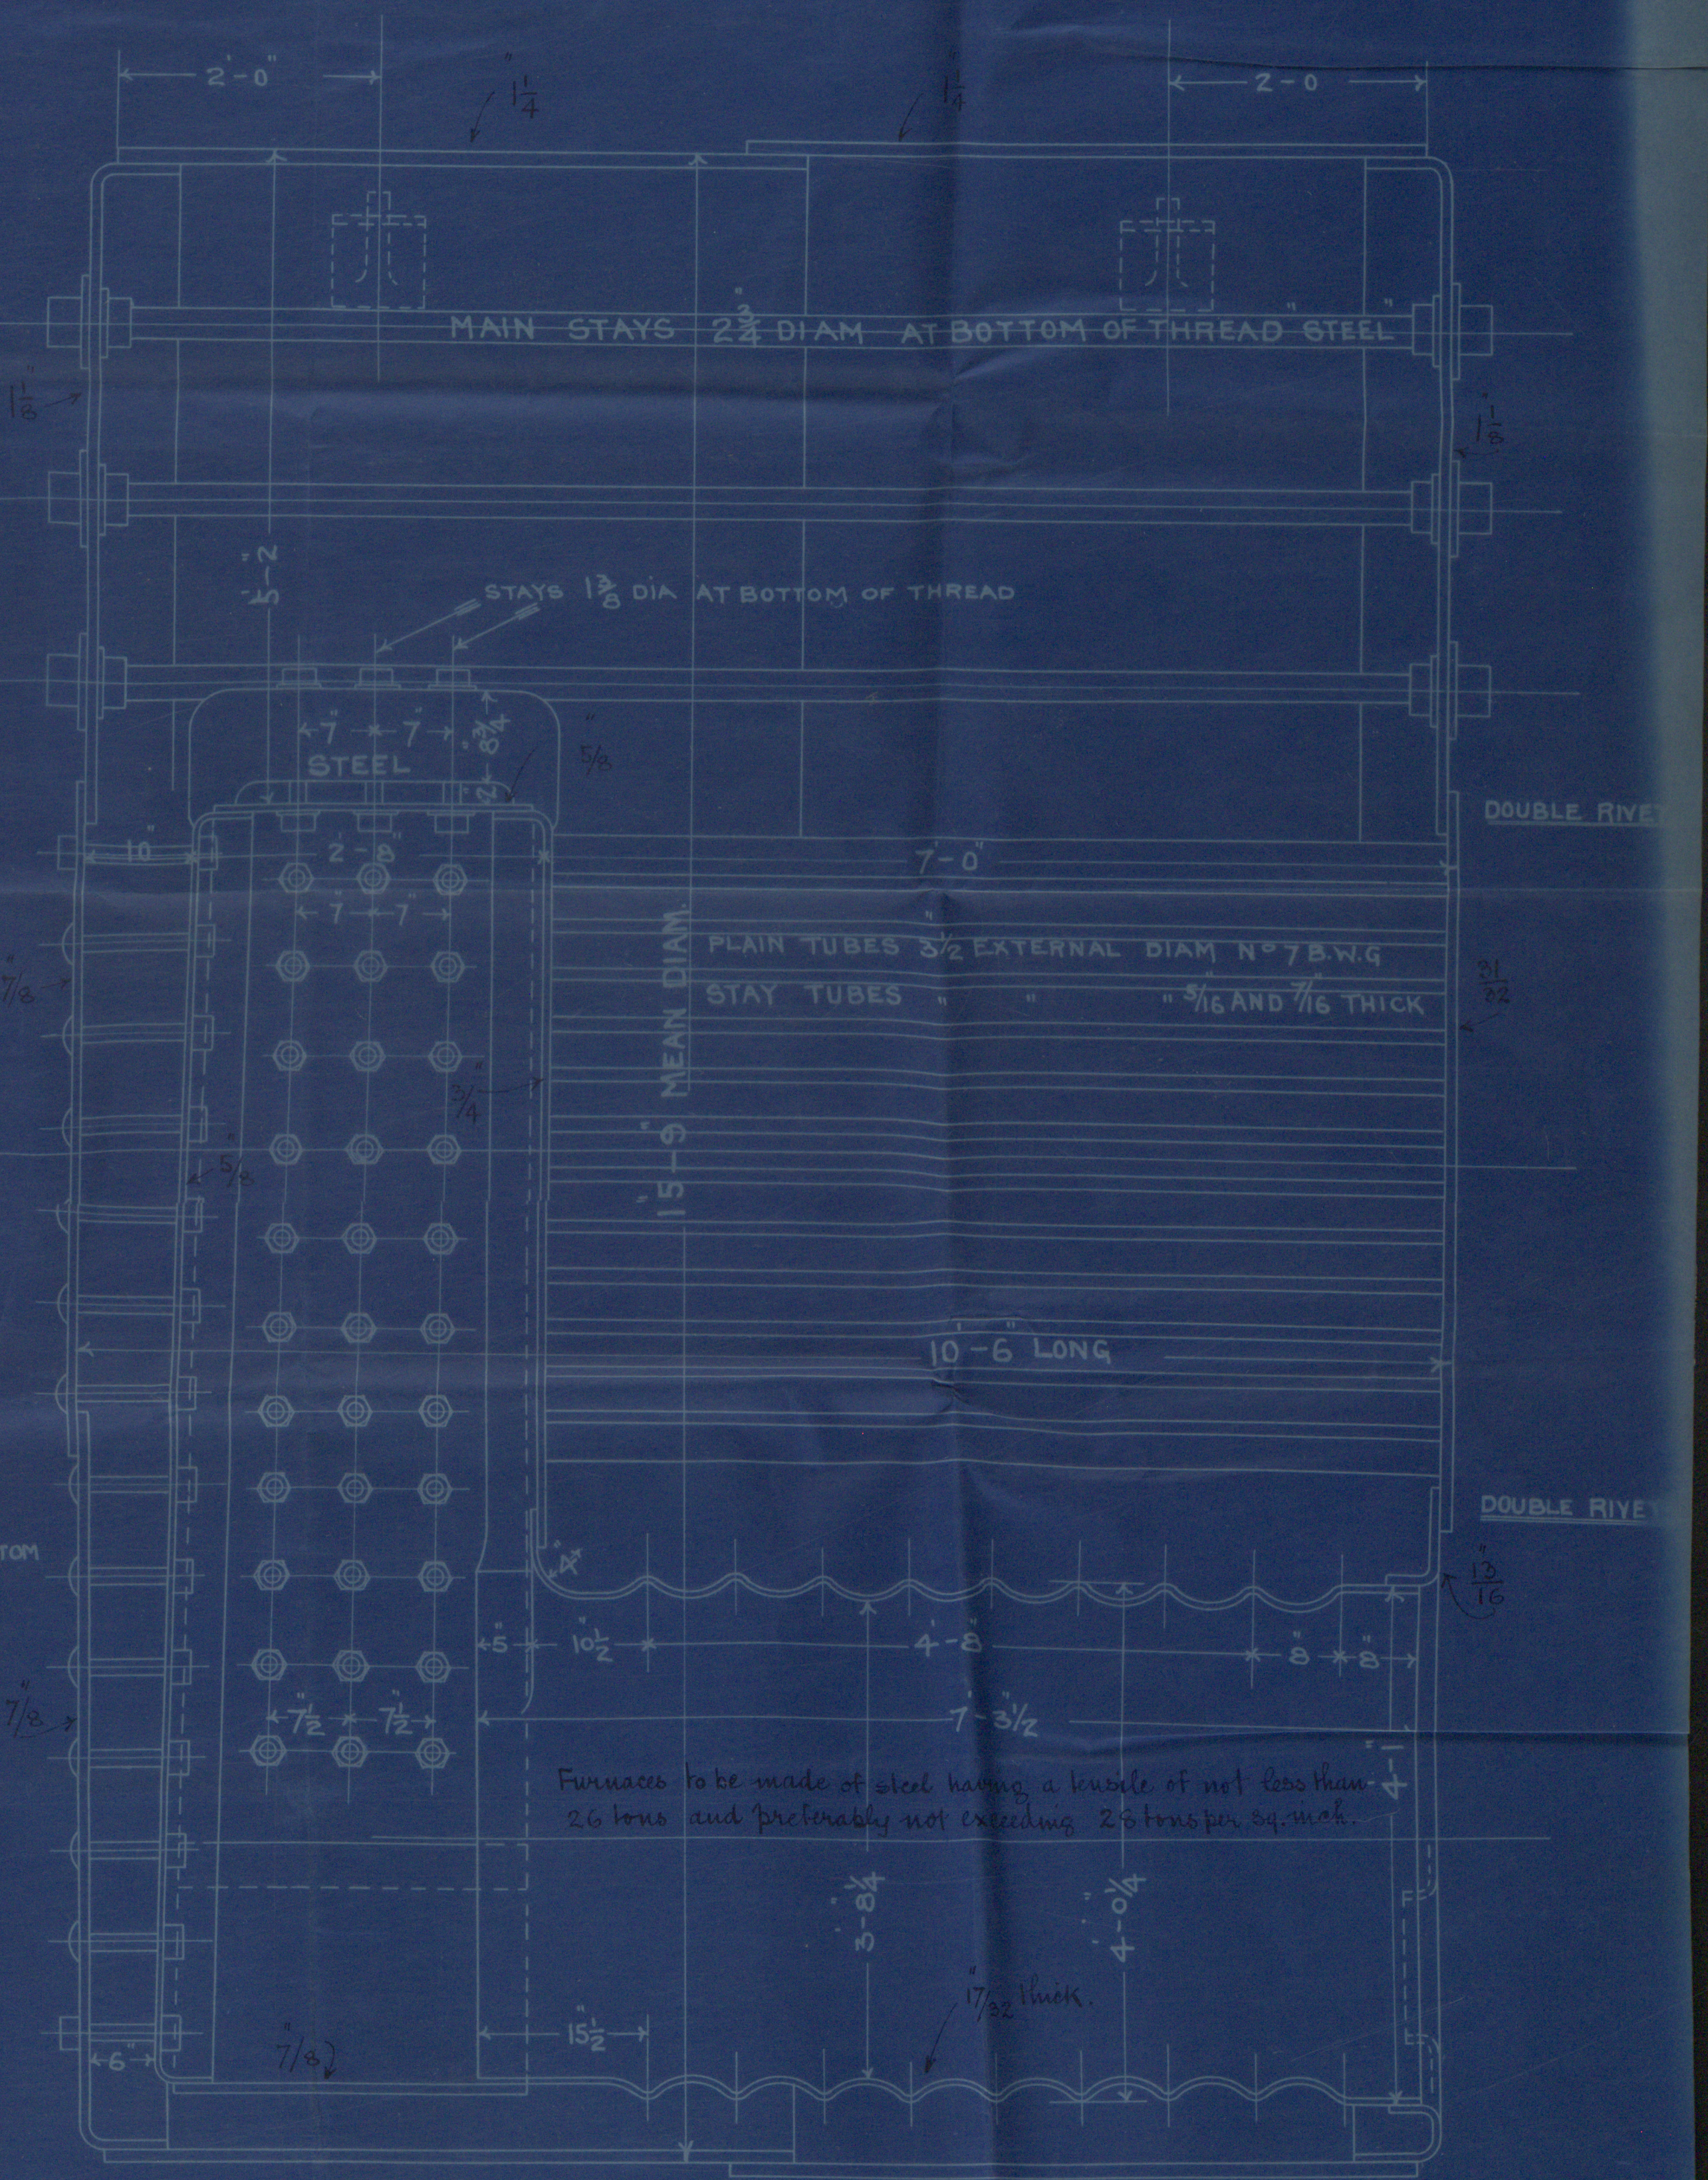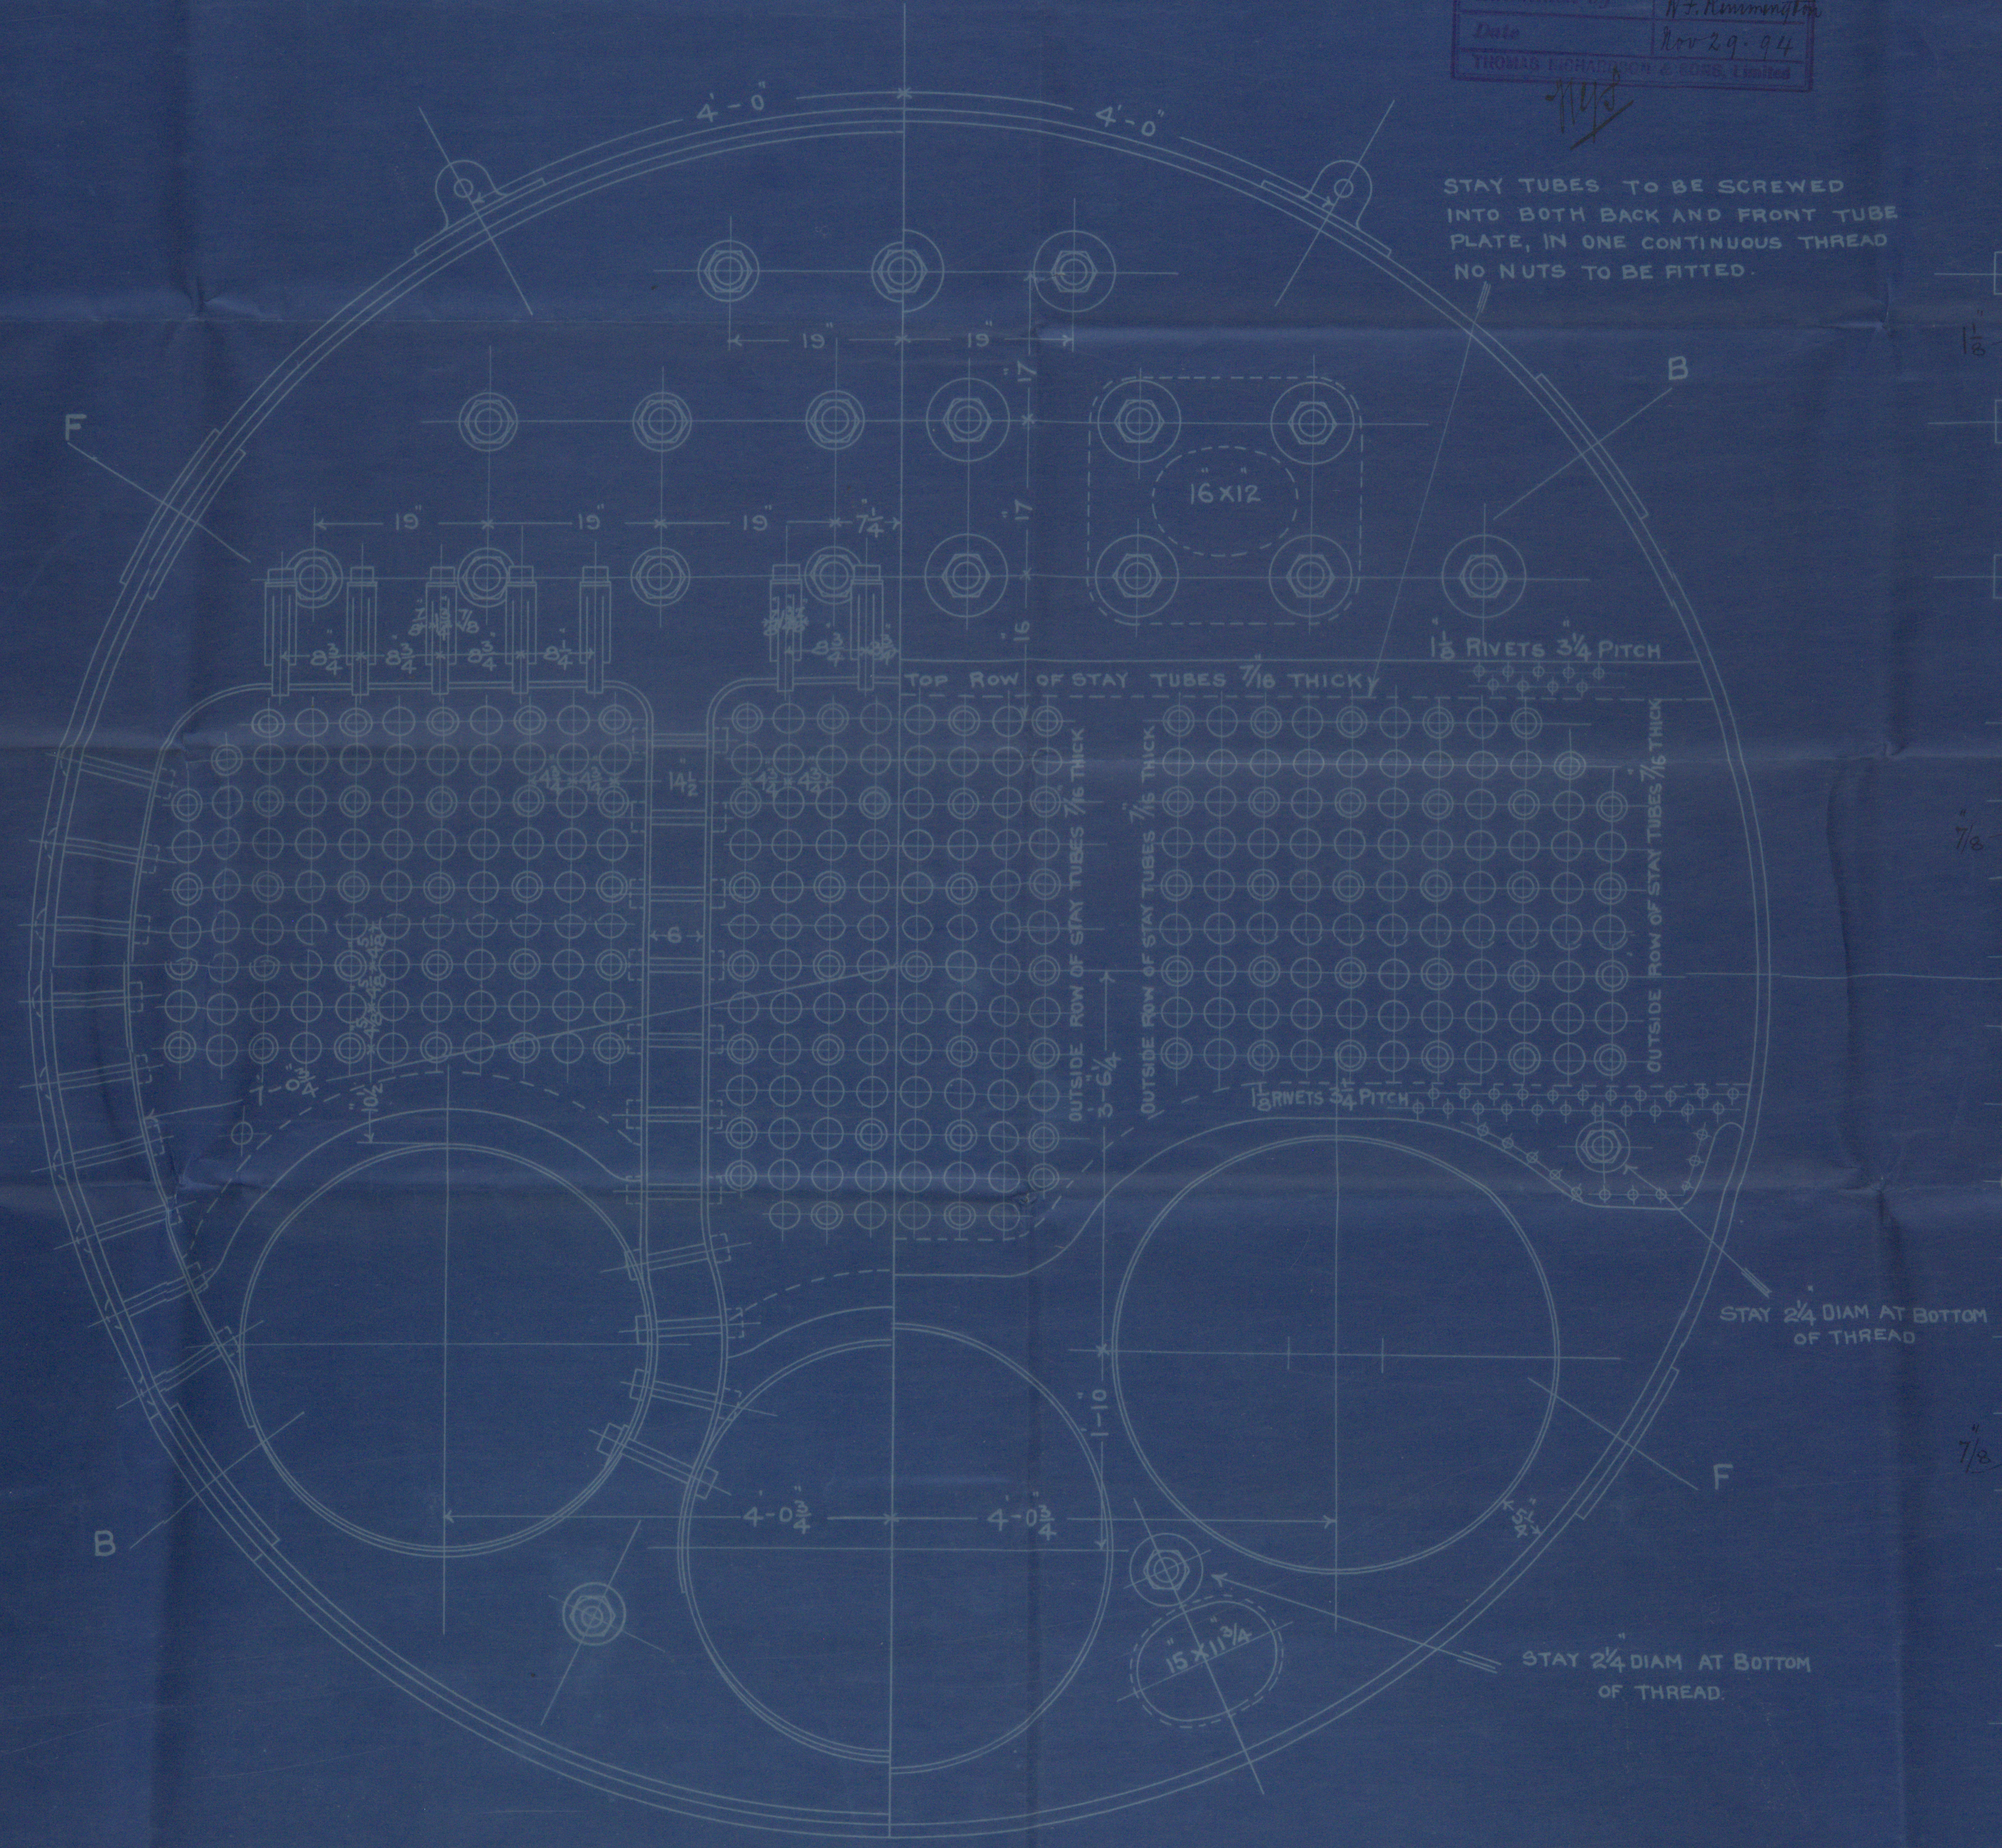

J.M.  
2/1/94





*Furness Pitby 78002*  
*wd 216*  
*Contract 1014*  
*2 off 160 lb*



*S.S. Lady Furness*  
*W. Hpl. Report No. 9752*  
*2478*  
*Lloyd's test*  
*330 lb*  
*18. 6. 95*

HPL 375-0152



© 2020

Lloyd's Register  
Foundation