


- No. 129 sp. -  
Suction to After Peak Tank.

$\frac{1}{8}$ " Scale

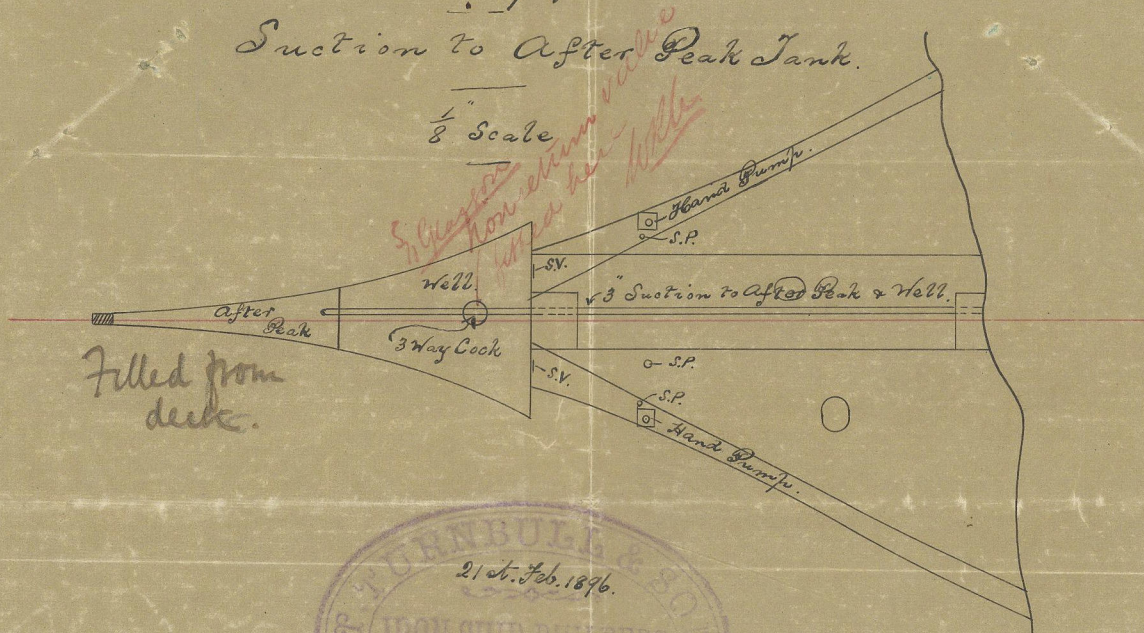

C.F.  
22.2.96



© 2020

Lloyd's Register  
Foundation

HPL 375-0162