


Mr. 17: 6: 95

No. 128 vs. and No. 129  
(Proposed)  
Pumping Arrangement.  
Scale  $\frac{1}{8}$  = One foot.



A. R. R.  
15.6.95

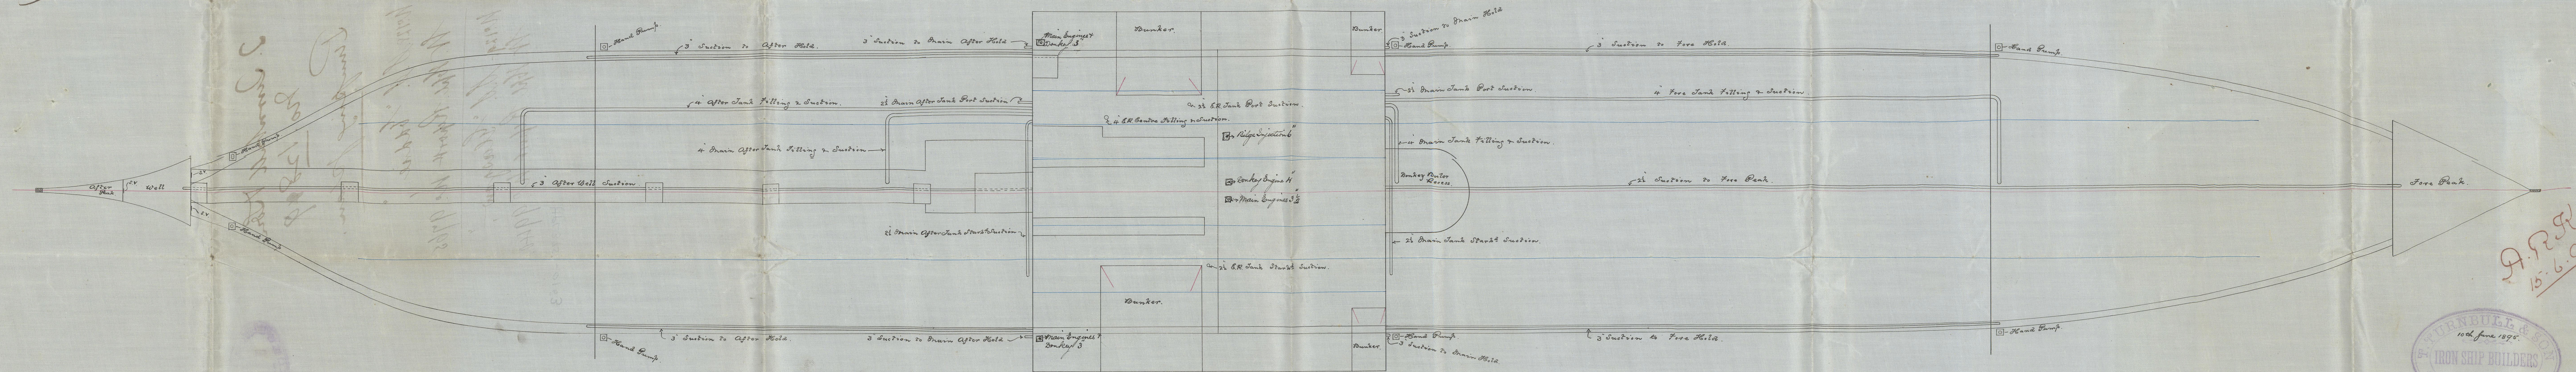



J. Turnbull & Son.  
No. 12849  
Pumping plan.

No. 128. S.S. "Eddie",  
W. Hpl. Report No. 9765

No. 129. S.S. "Glasgow",  
W. Hpl. Report No. 9940.

HPL 375 - 0163



© 2020

Lloyd's Register  
Foundation