

J.S. Ydnie

Received at **WEST HARTLEPOOL** Office.

9. 8

Lloyd's Register of British and Foreign Shipping.

(Report on Vessel No. 9765 Port WEST HARTLEPOOL)

W. pool

No. 2949a SHIP FORGINGS OR CASTINGS.

I have to report that the undermentioned Iron or Steel Forgings or Castings, manufactured by Mr Tho Ray of Pallion for the Vessel No. 128, being built by Messrs J Lumbull Son of Whitley have been inspected by me as set forth below, and found to be, so far as can be seen, sound.

The words FORGINGS or CASTINGS, IRON or STEEL, should be struck out as may be required.

Mark on Forgings.

Lloyd's
No. 2949a
W. L.



Wm H Cameron

Sunderland

8. 8. 95.

	STERN FRAME.	RUDDER FRAME.	STEM.
Material*	<i>Scrap iron</i>	<i>Scrap iron</i>	<i>Scrap iron</i>
How made	<i>Forged</i>	<i>Forged</i>	<i>Forged</i>
Dimensions	<i>10' x 6'</i>	<i>8' - 4"</i>	<i>10' x 2 3/4"</i>
Progress on Inspection	<i>Forged & Smithed</i>	<i>Forged & Smithed</i>	<i>Forged</i>
Date when Inspected	<i>Jan'y 17th to Feb'y 27/95</i>	<i>May 9th to July 8/95</i>	<i>March 5-8/95</i>

SKETCHES OF FRAMES SHOWING POSITION AND DESCRIPTION OF WELDS OF FORGINGS, OR PARTICULARS OF TESTS APPLIED TO CASTINGS.

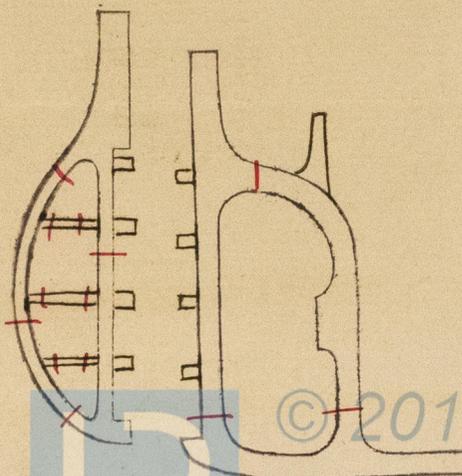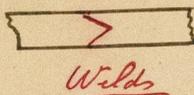

Fee (if any chargeable) £ : :

To be paid at

© 2019 Lloyd's Register Foundation