

Steel.

Tracing of Meredith Patent Vertical Multitubular Boilers

13.6 high x 6.3 Dia




Lloyds Survey 80 lbs W.R.

Messrs Turnbull & Sons 95 St.

Boiler No 1903.

Scale 1" = 1 foot

Mantle in this plate.

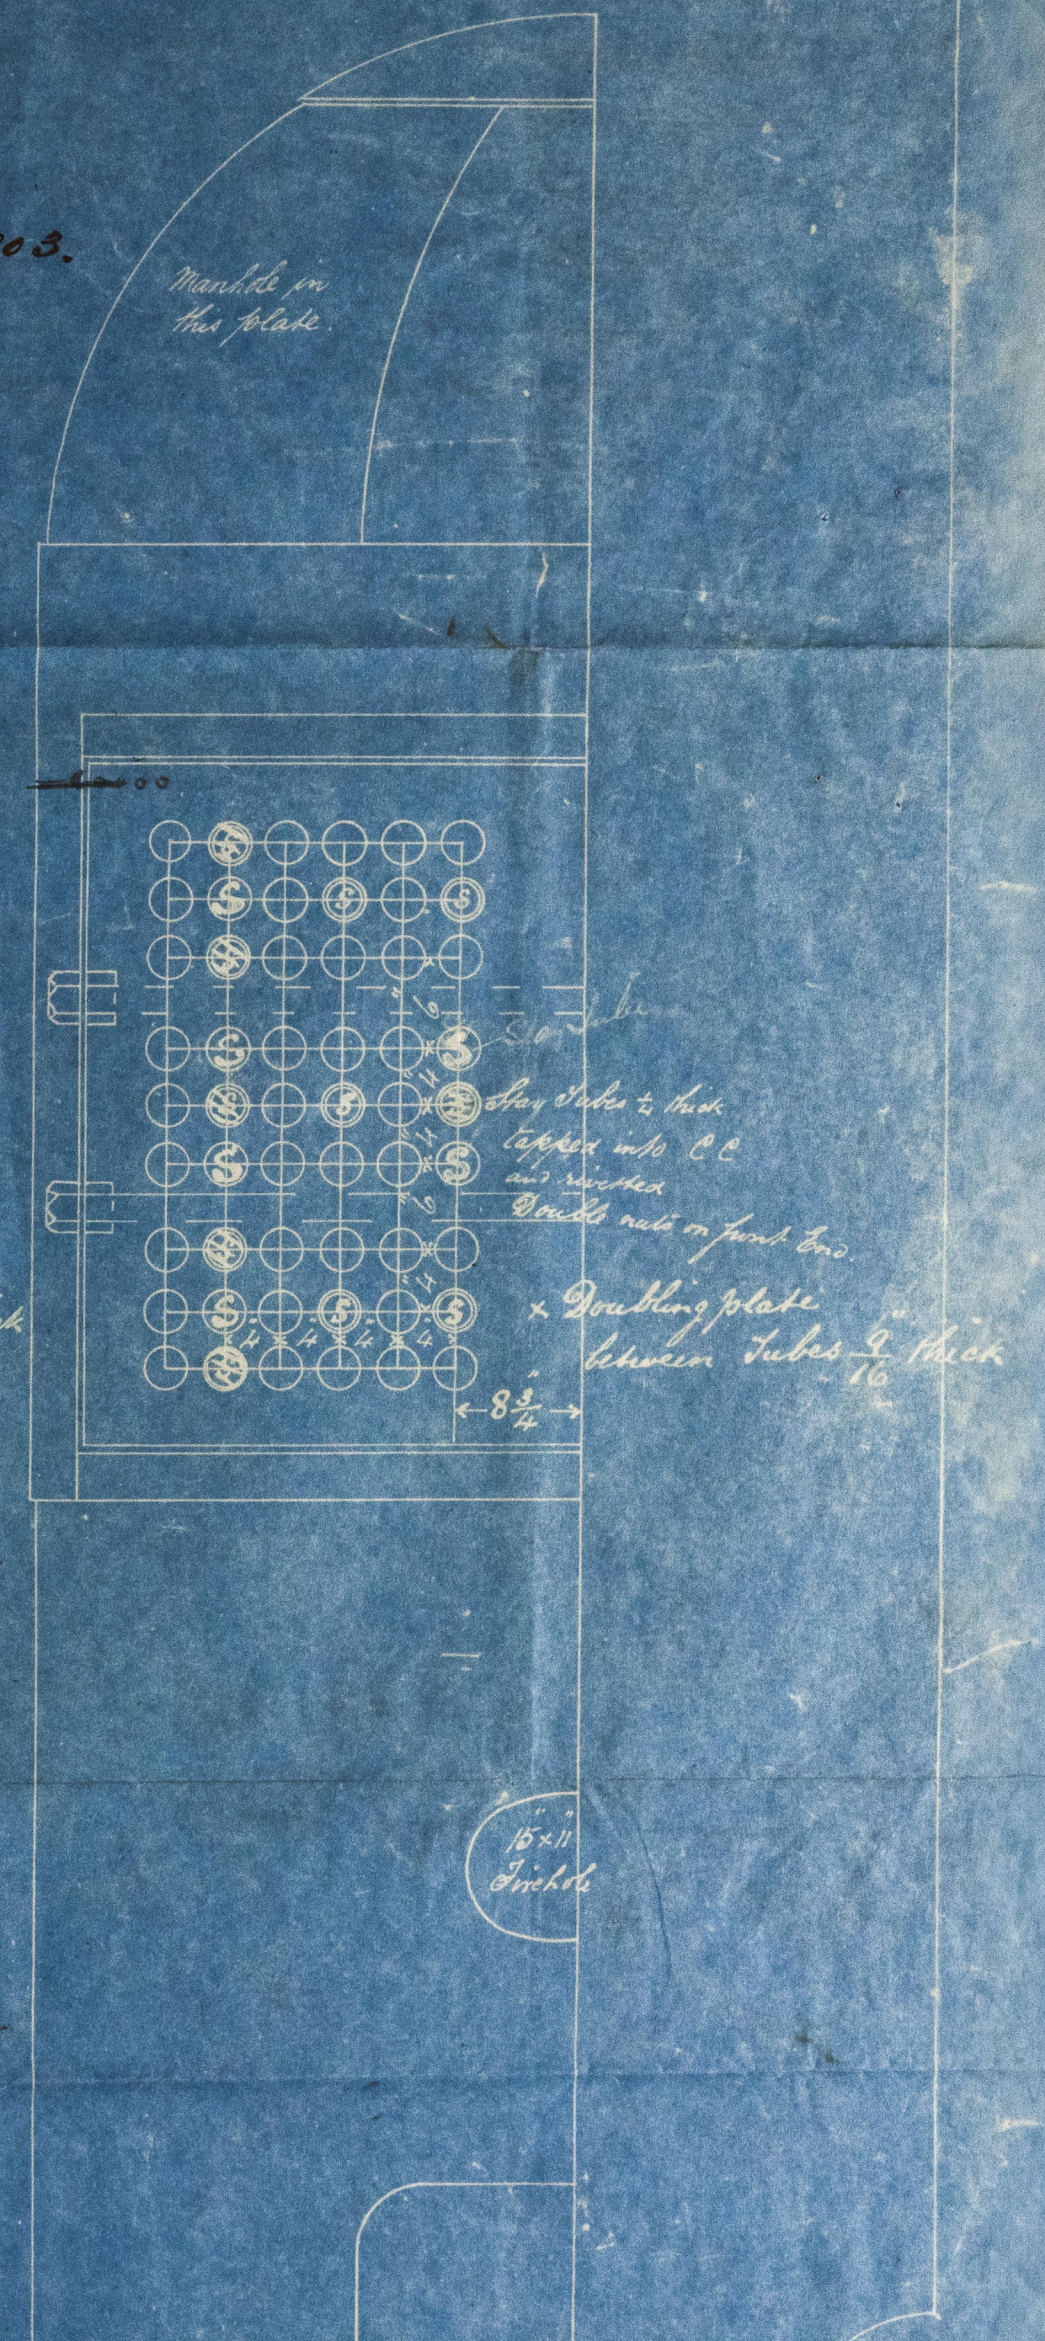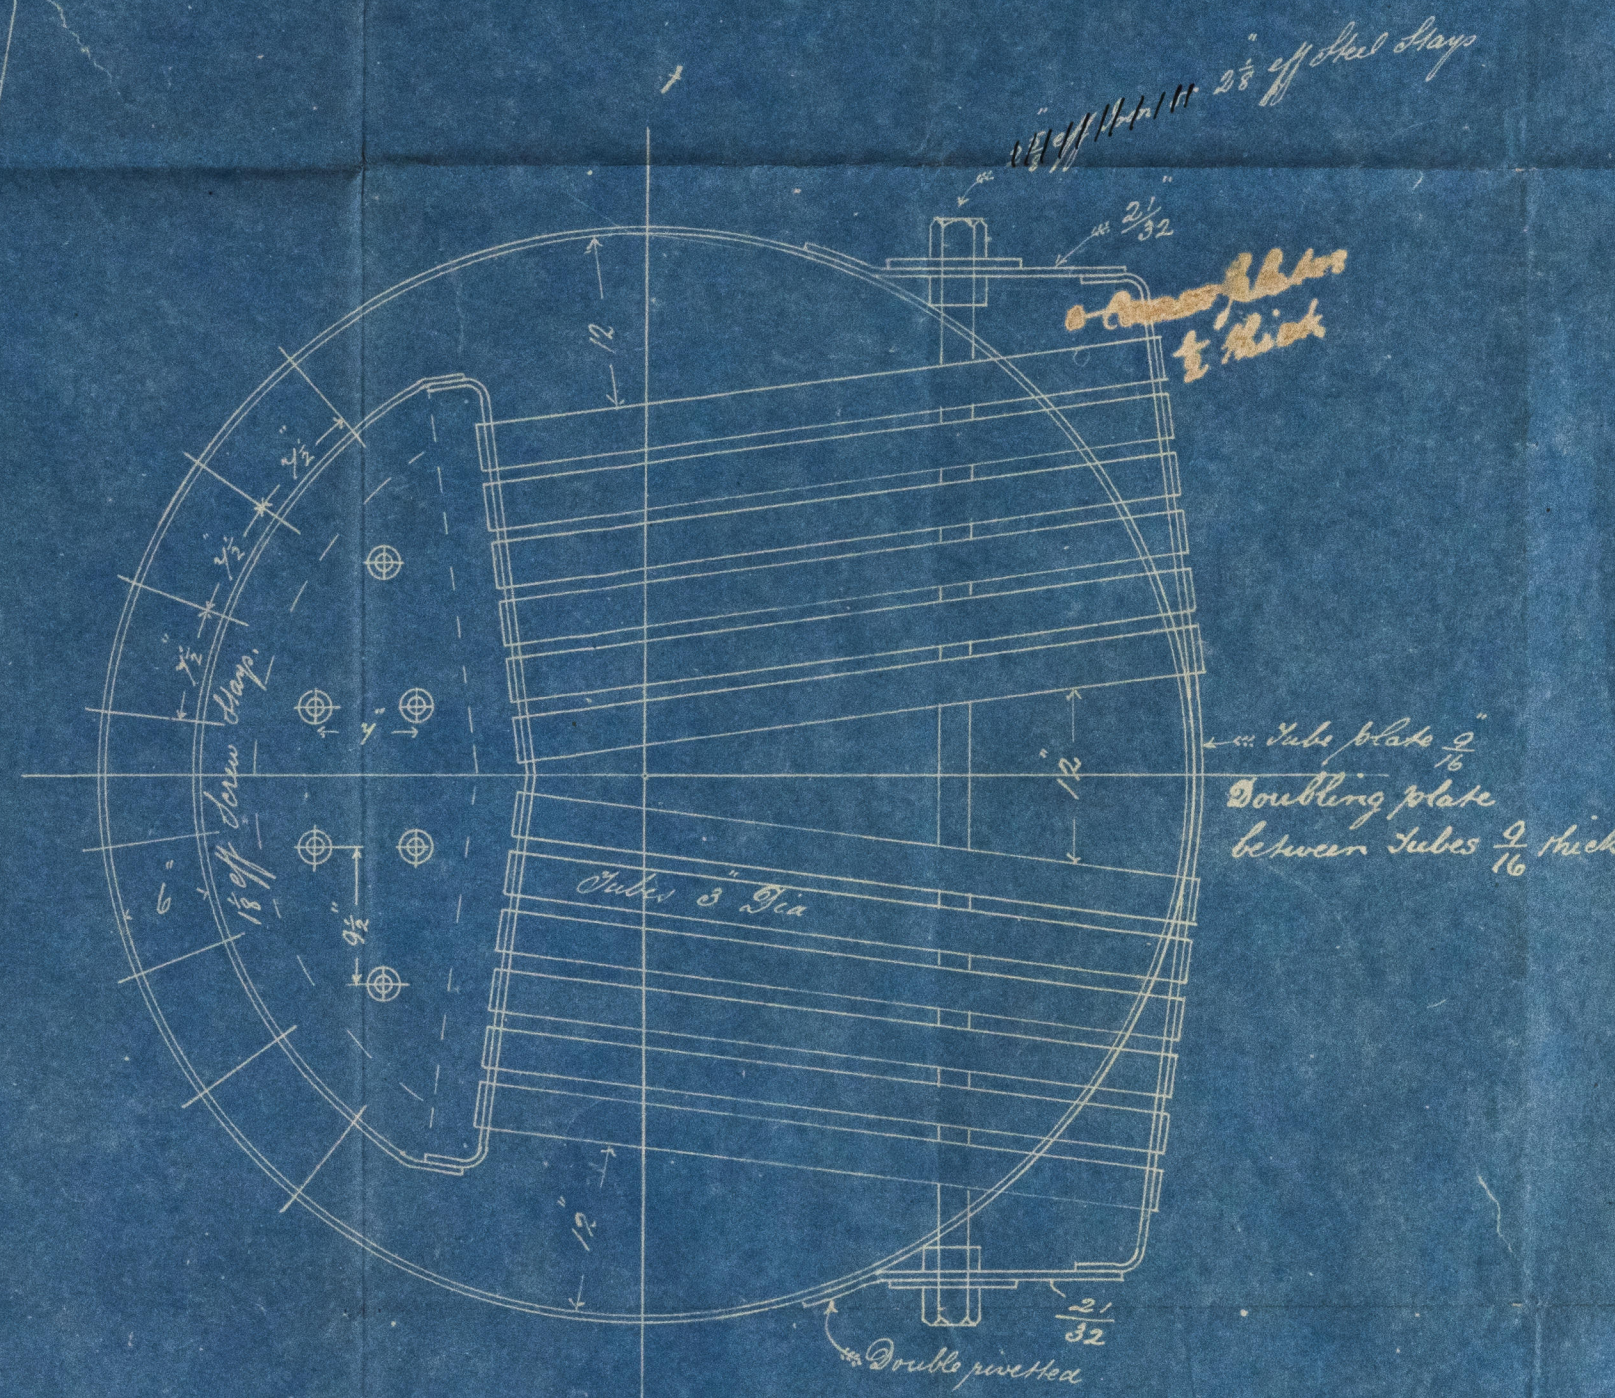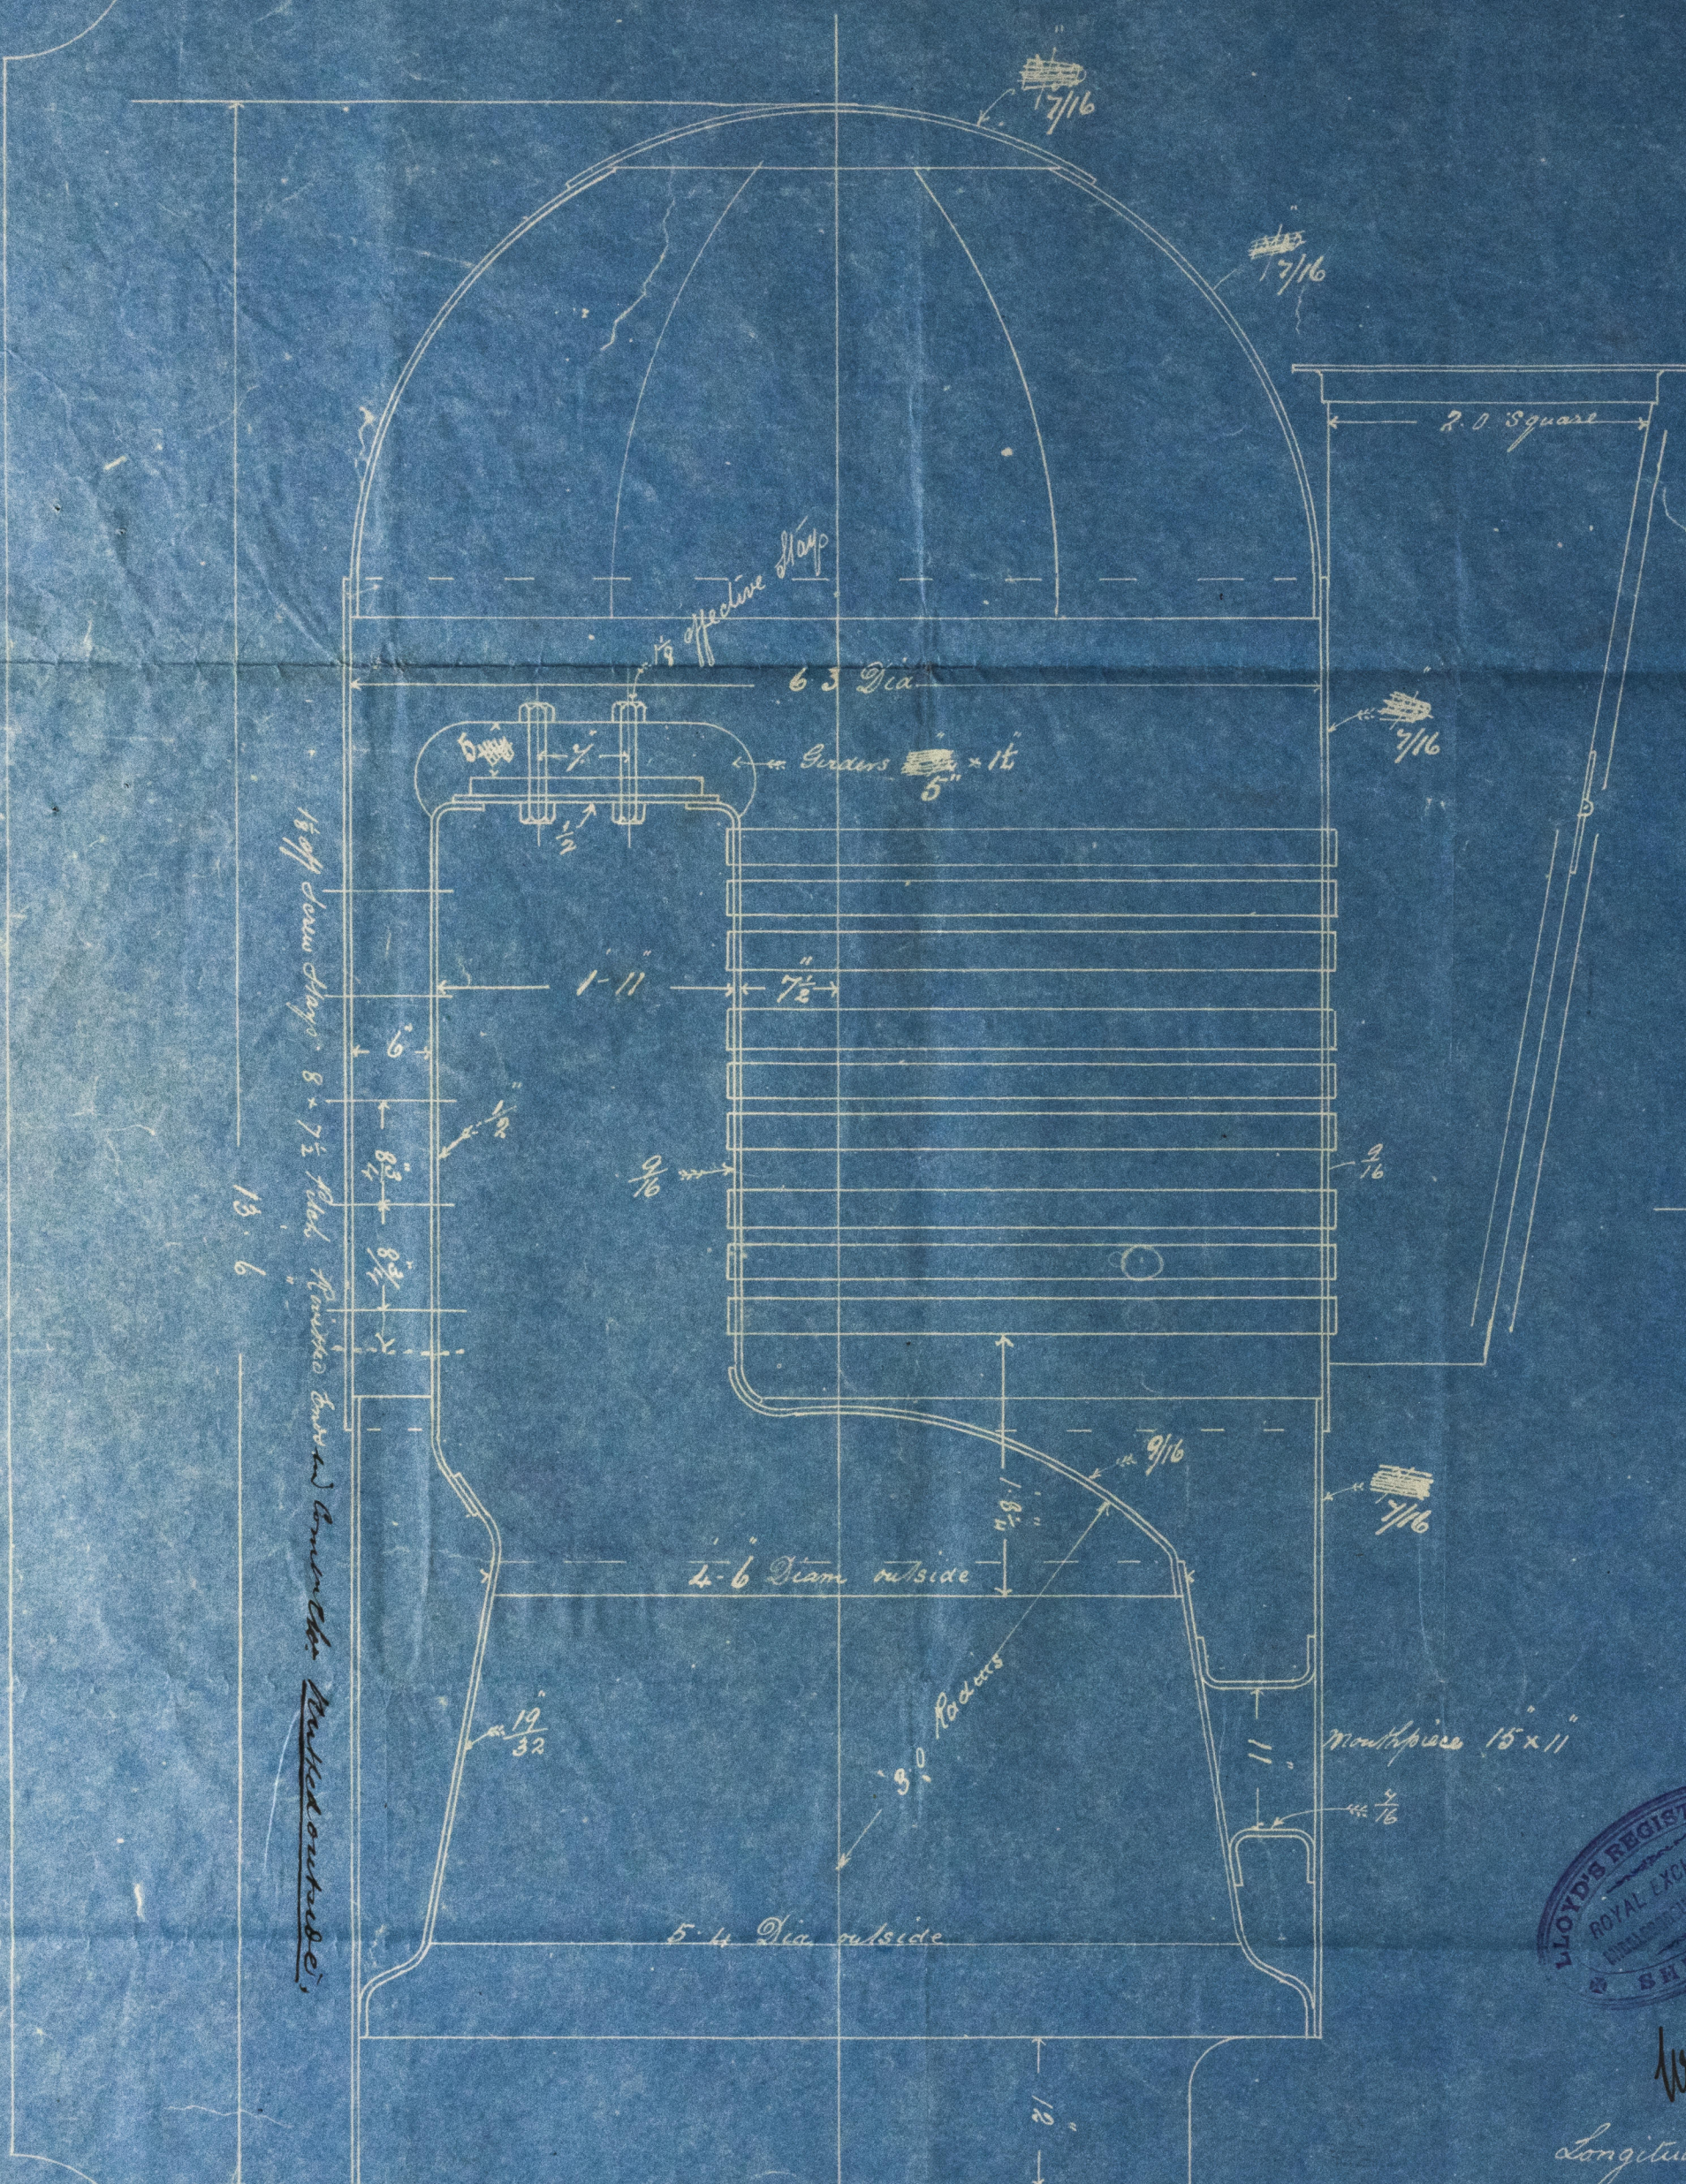

W.H. 23rd June 1891

Longitudinal seams in shell Lap joints Double rivetted  
remainder of Boiler Single rivetted

7/8 holes x 3/8 pitch  
1/2 x 2  
7/8

Messrs. R. & S. 26, 27, 28, 29  
Riverside Works





~~F. Funnell & Sons~~

~~No 128~~

80 lbs <sup>sq</sup> compressor

s/s "Eddie"

Intro report No. 15-66

W. Hpl. Report No. 9765

HPL 375-0166



© 2020

Lloyd's Register  
Foundation