

LLOYD'S REGISTER  
 21. 2. 94  
 7. 8. 94  
 8. 10. 94  
 16. 10. 94

No. 218, approved  
 11. 4. 95


# PROFILE OF PROPOSED ARRANGEMENT

SCALE  $\frac{1}{8}$ " = 1 FOOT.

BULB ANGLE FRAMES IN ONE LENGTH FROM TANK SIDE TO BRIDGE DECK

Main & raised quarter decks  
 supported by frame spaces  
 See 4 & 5 plan 7

web & beam  
 also shafts  
 to frames 5-8

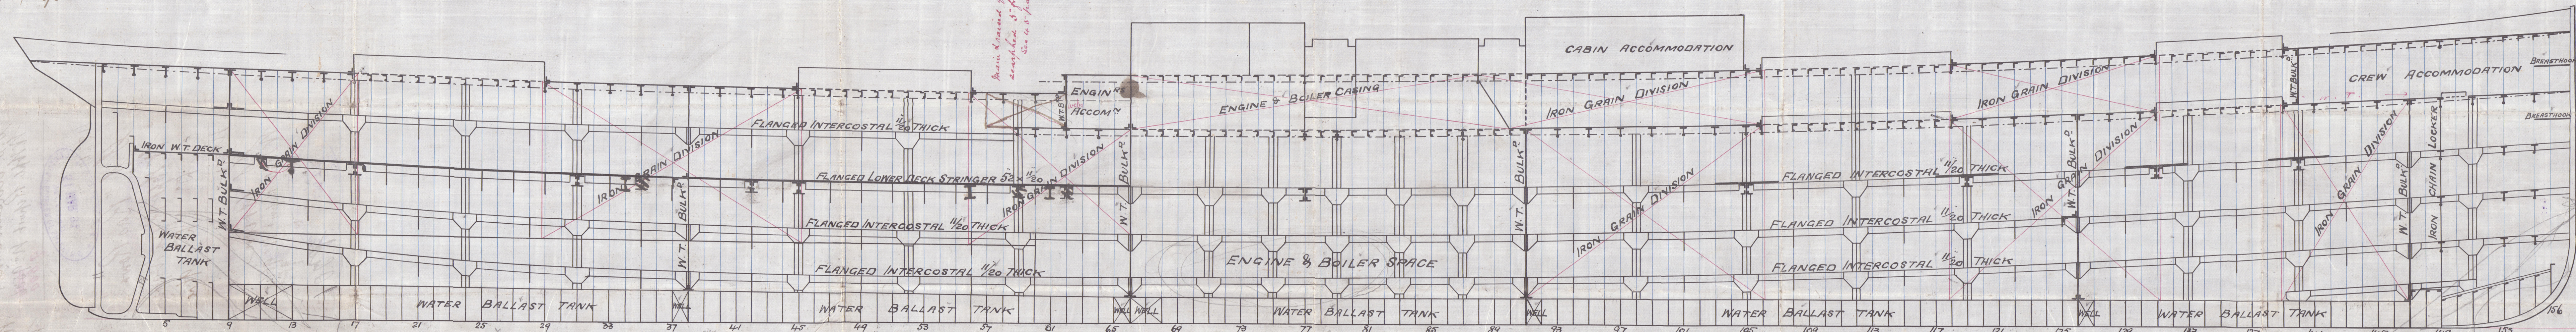

No. 210. 211. 212. & 218

2nd End  
 to No. 218

approved  
 26. 2. 94  
 C.F.  
 SHIP

FURNESS, WITHEY & CO., LIMITED  
 TRACING No. 11859  
 SHIPBUILDERS & REPAIRERS.  
 FEBRUARY 6th 1894

Lloyd's Register  
 Foundation

HPL376-0122




Jumess Witting & Co.

X No. 210, 11, 12, 18

Profile

S.S. Ailsa, wald,  
W. H. Rpt No. 9506  
9600

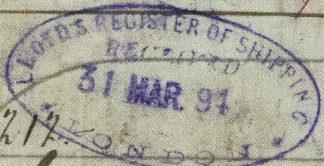

No. 217


S.S. "Ras Rona"

W. H. Rpt No. 9596  
No. No. 9620

No. 211

S.S. "Arion"

W. H. Rpt No. 9669  
9689

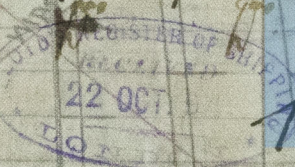

P. J. O.

X

No. 218. S.S. Ras Elia  
W. H. Rpt No. 9777  
No. No. 9827

SIS SIS

© 2020

Lloyd's Register  
Foundation