

No. of Tracing	3477
No. of Drawing	—
Where Sent	Lloyds Surveyors
Examined by	R.R. J.B.
Date	April 18. /95
THOMAS FICHARDSON & SONS, Limited	

Boulders 1019

7

Y
Burnup Drilling 800
No. 218

Contract 1019

H. P. 100 lb

SS. RAS. ELLA


W. H. P. Report No. 9827

24 8 24


Lloyd's test

320 lb

19. 8. 95

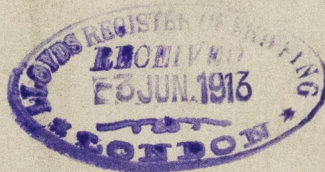

HPL376-0124

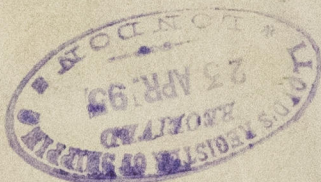

© 2020

Lloyd's Register
Foundation