



VERT^l STEEL BOILER

14'0" x 7'0"

SCALE 1 INCH TO A FOOT

WORKING PRESSURE = 80 LBS "H"


MESS^{rs} FURNESS, WITBY & CO LIMITED

N^o 196 S.S.

Order 895

To Pass Lloyds Survey

Length 14'0"

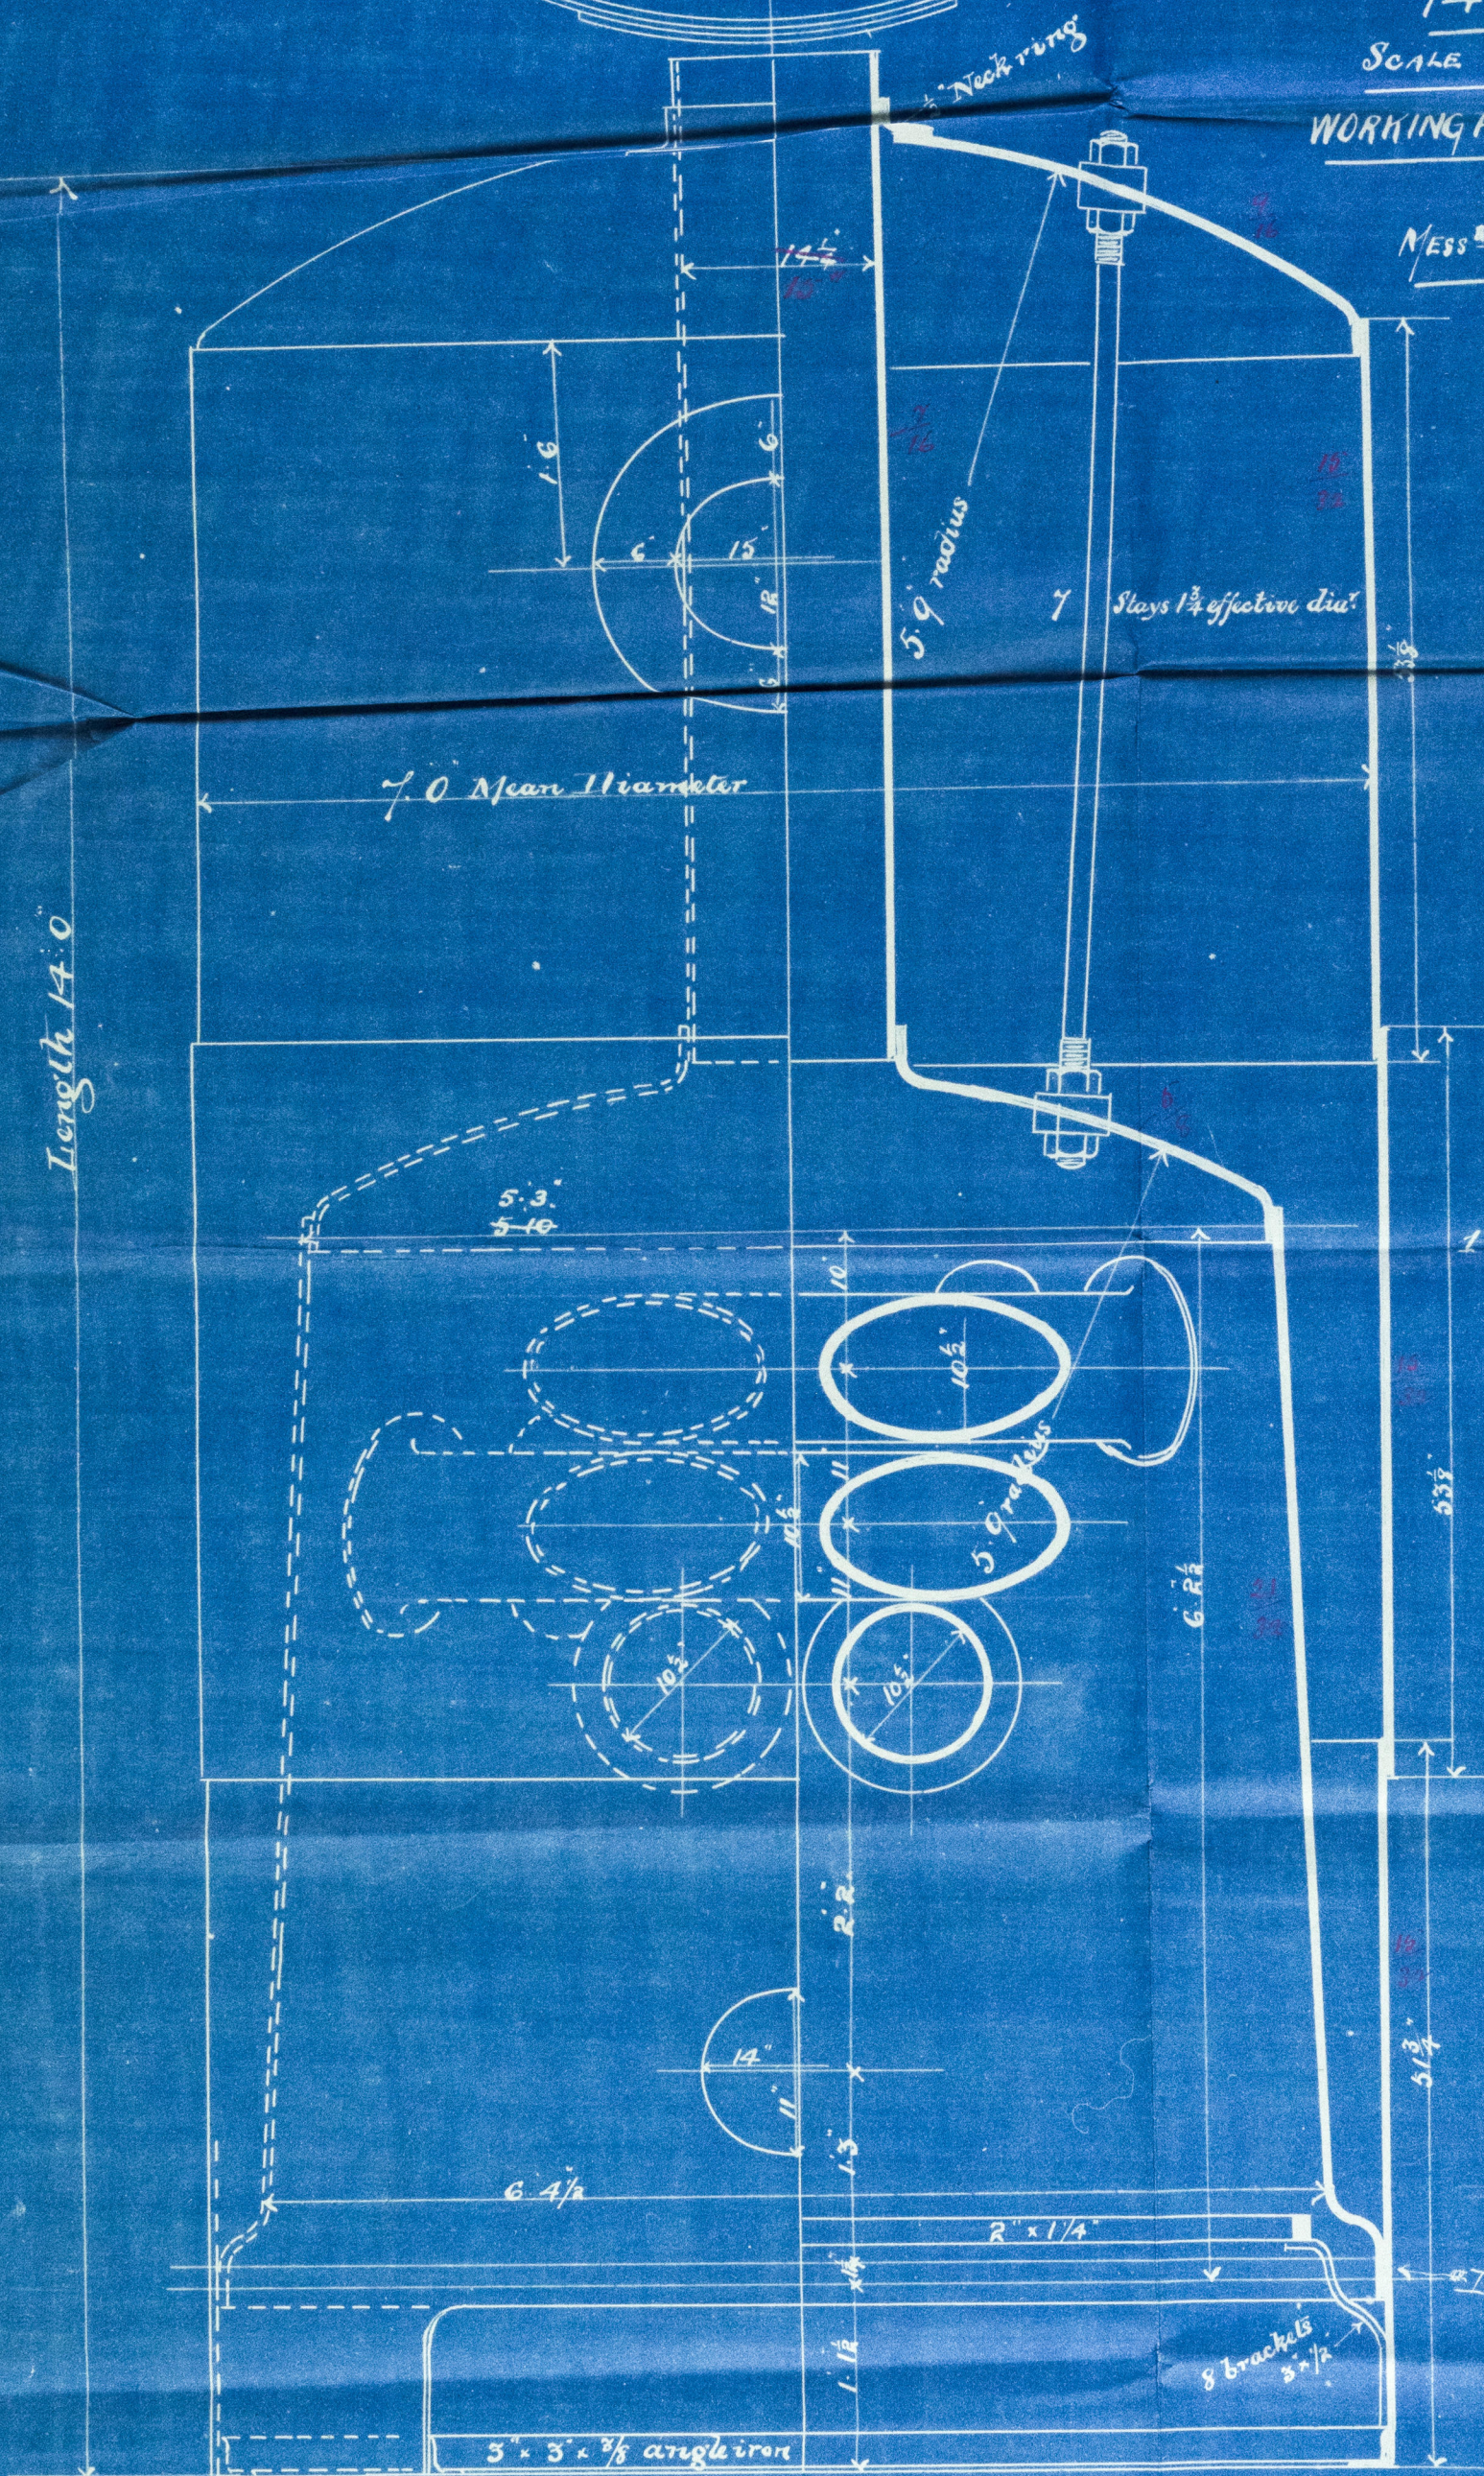

1 Hand hole at each end of each tube



4 Mudholes round base

Double riveted

Circular Seams Single riveted $\frac{13}{16}$ Rivets R Pitch
Vertical " double " $\frac{13}{16}$ " $R \frac{8}{7}$ "

THE SUDRON & CO LTD
IMPERIAL BOILER WORKS
STOCKTON-ON-TEES.

29/8/92

HPL3/6 - OV/5



© 2020
Lloyd's Register
Foundation

Furness Withy 1884²

N^o. 218 vessel

88thth Working Press^m

S.S. "Ras Elba",
W. H. P. Report N^o. 9827

HPL376-0125



© 2020

Lloyd's Register
Foundation