

J.S. Rasbwa

Lloyd's Register of British and Foreign Shipping.

West Hartlepool (Report on Vessel No. 9827 Port **WEST HARTLEPOOL**)

No. 3025.a. SHIP FORGINGS OR CASTINGS.

I have to report that the undermentioned Iron or ~~Steel~~ Forgings or Castings, manufactured by *The Stockton Forge Co.* of *Stockton* for the Vessel No. *218*, being built by *Wm's & James Hilly Co.* of *Wartlepool* have been inspected by me as set forth below, and found to be, so far as can be seen, *sound.*

The records FORGINGS or CASTINGS, IRON or STEEL, should be struck out as may be required.

Mark on Forgings.

Lloyd's


No. 3025.a
No. 6.

*Wm's & James Hilly
Sunderland*

3.9.95

	STERN FRAME.	RUDDER FRAME.	STEM.
Material*	<i>Scrap iron</i>	<i>Scrap iron</i>	<i>Scrap iron</i>
How made	<i>Forged</i>	<i>Forged</i>	<i>Forged</i>
Dimensions	<i>10" x 6"</i>	<i>8" x 4"</i>	<i>10" x 2 3/4"</i>
Progress on Inspection	<i>Forged & Smithed</i>	<i>Forged & Smithed</i>	<i>Forged</i>
Date when Inspected	<i>May 7th to 30/95</i>	<i>June 13th to Aug 15/95</i>	<i>May 25/95</i>

SKETCHES OF FRAMES SHOWING POSITION AND DESCRIPTION OF WELDS OF FORGINGS, OR PARTICULARS OF TESTS APPLIED TO CASTINGS.

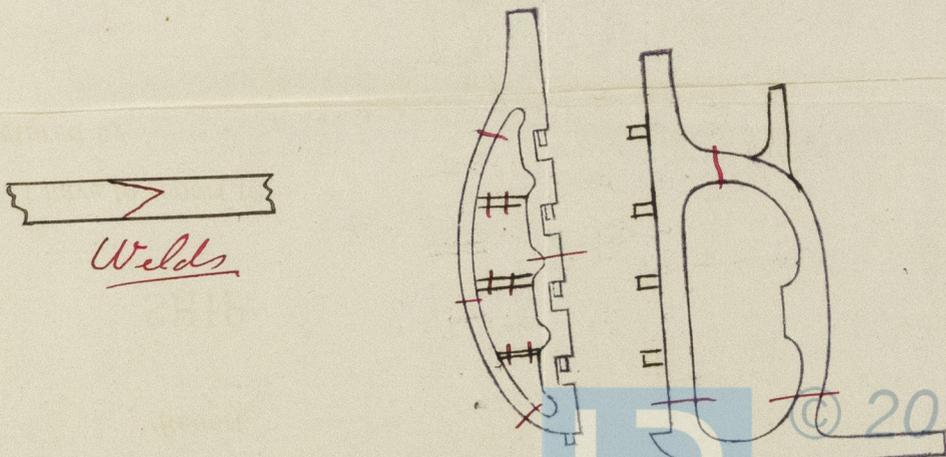

Fee (if any chargeable) £ : :

To be paid at

* If of Iron, state whether scrap or puddled Iron.

