


Lloyds Survey

PLAN OF IRON LOWERMASTS


FOR FURNESS WITHEY & CO. L^d N^o. 220. S/S.

Masts to be made in two plates in the round
 Butts below dk double riveted, above dk treble riveted; straps to be thicker than plates; Seams single riv
 $\frac{3}{4}$ rivets, 5' diam apart
 Masts to carry fore & aft sail only

FOREMAST.

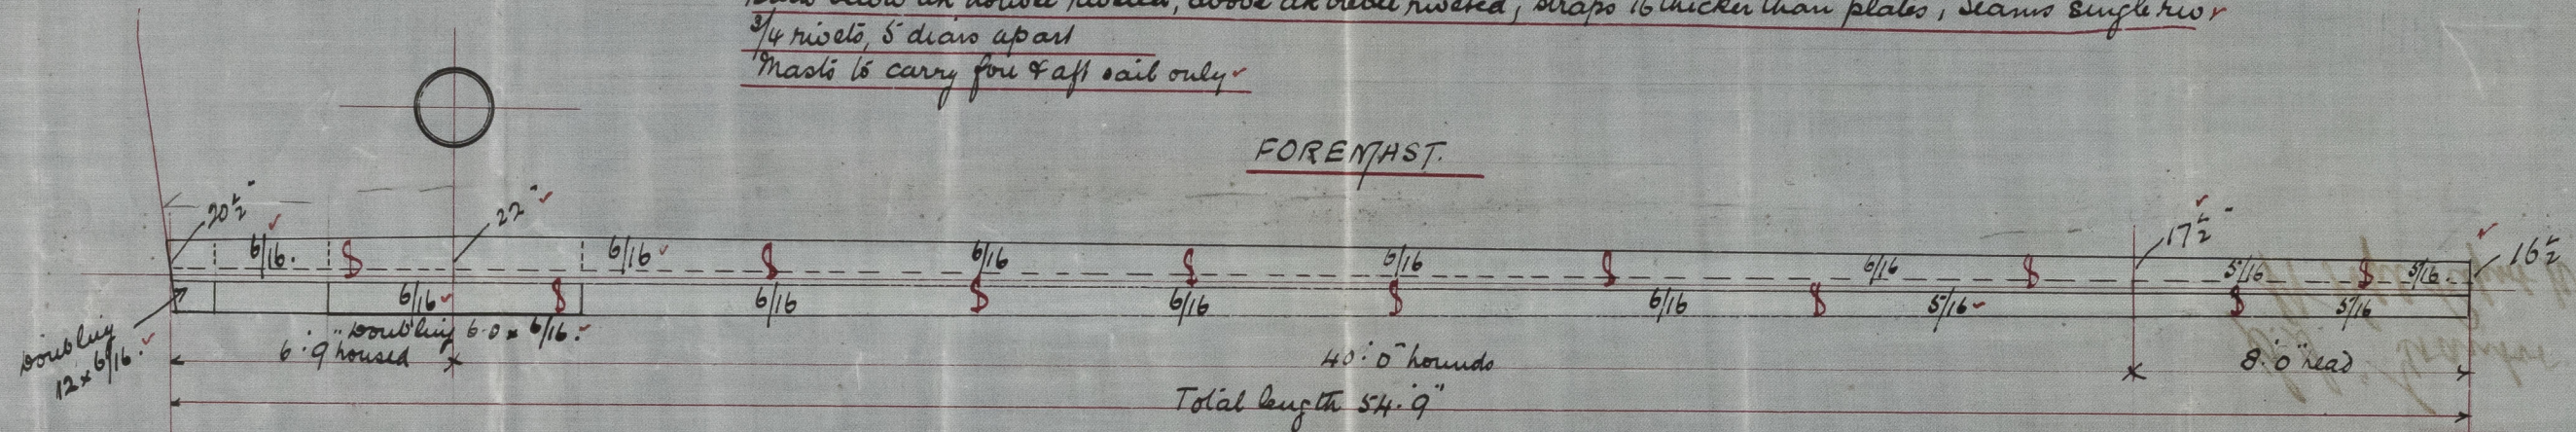

MAINMAST.

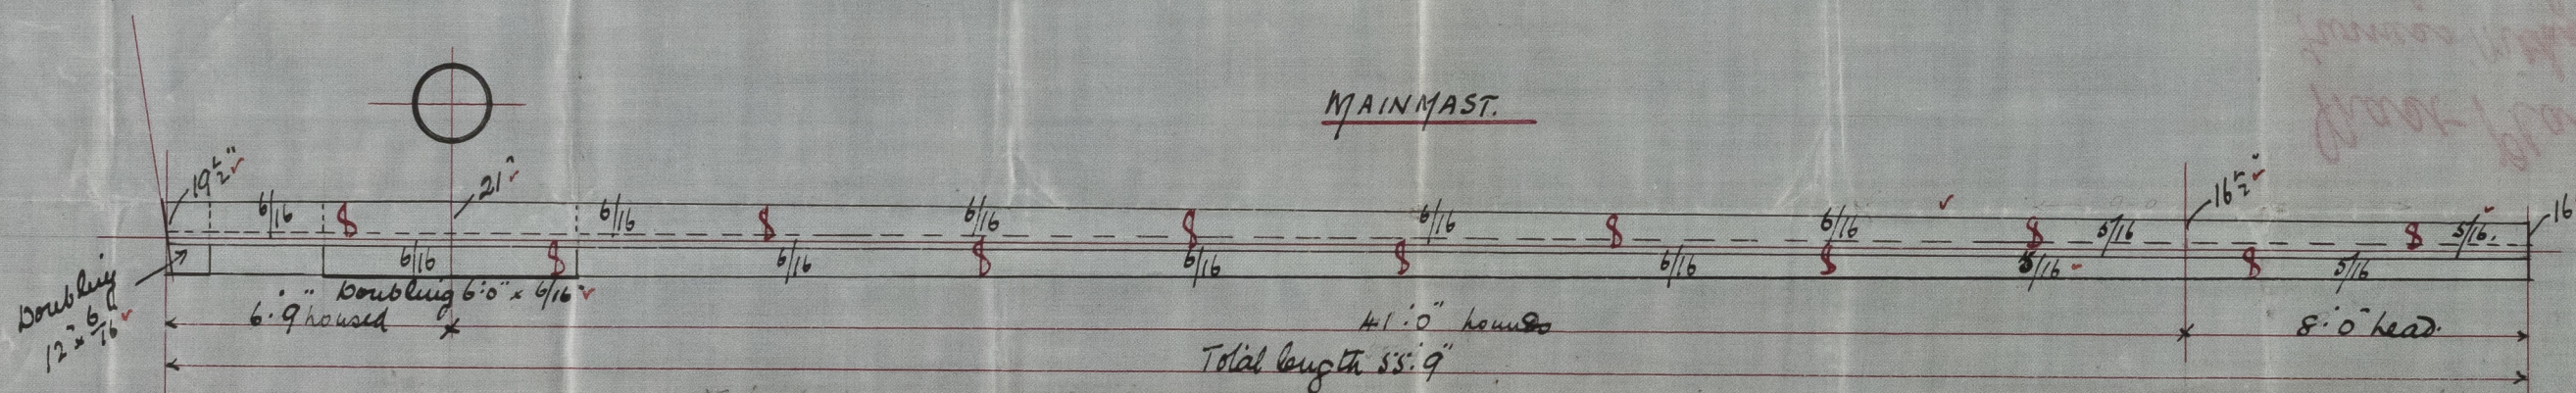



Thast-Plan
Furness Mill, 1898
No. 220

J. D. "Grantor",
H. H. Pl. Report 189869

HPL376-0221



© 2020
Lloyd's Register
Foundation