


7.6.95

PROFILE.



BULB ANGLE FRAMES IN ONE LENGTH FROM TANK SIDE TO RUNNING DECK

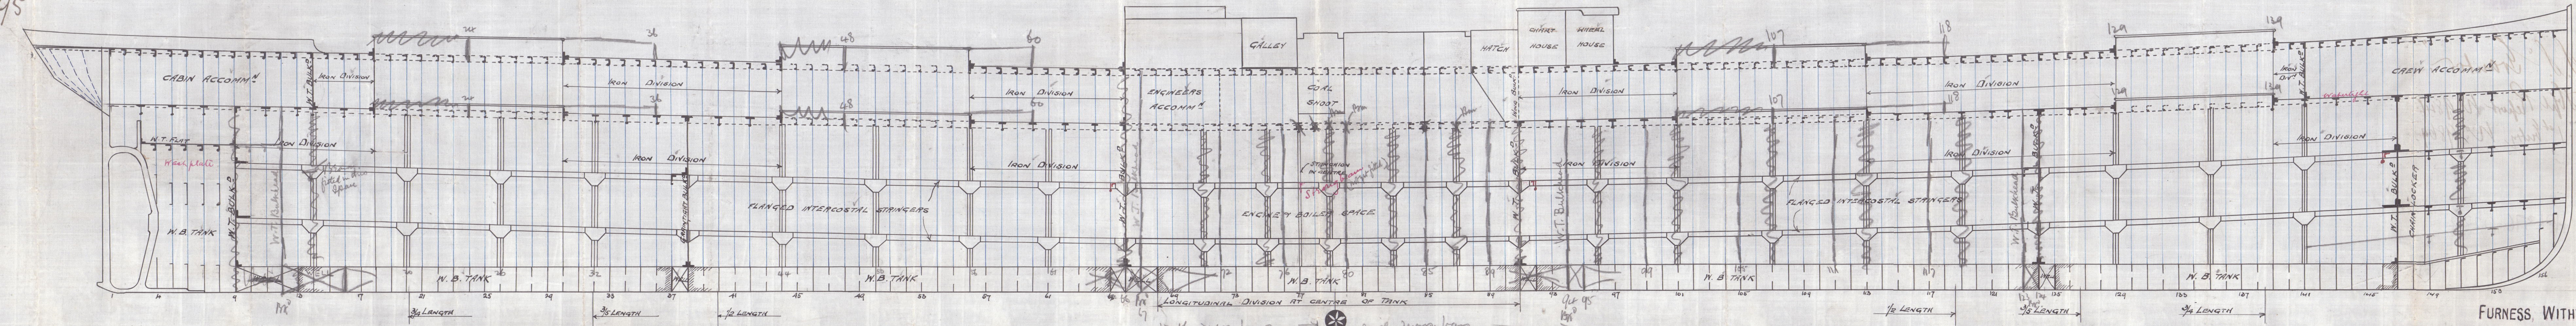

Nº 220.

— SCALE $\frac{1}{8}$ = ONE FOOT —
 ← Floor plate on every frame in E.T.B. space →
 1/16" iron in Engine room 1/16" iron in Boiler room
 Additional bars to be fitted

FURNESS, WITBY & CO., LIMITED
 SHIPBUILDERS & REPAIRERS
 WEST HARTLEPOOL.
 24TH MAY 1895.

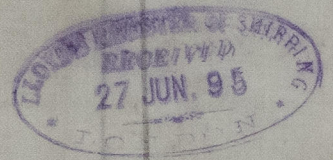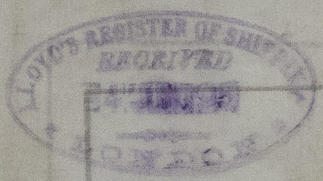

Furness Withy & Co.
No. 220.

Profile.

W. Hpl. Report No. 9706

S. S. Granton,
W. Hpl. Report No. 9846
No. 1st Butty No. 9869.



SHIPBUILDERS & REPAIRERS
FURNESS, WITHEY & CO. LIMITED



© 2020
Lloyd's Register
Foundation