


MIDSHIP SECTION


SCALE $\frac{1}{2}$ = ONE FOOT

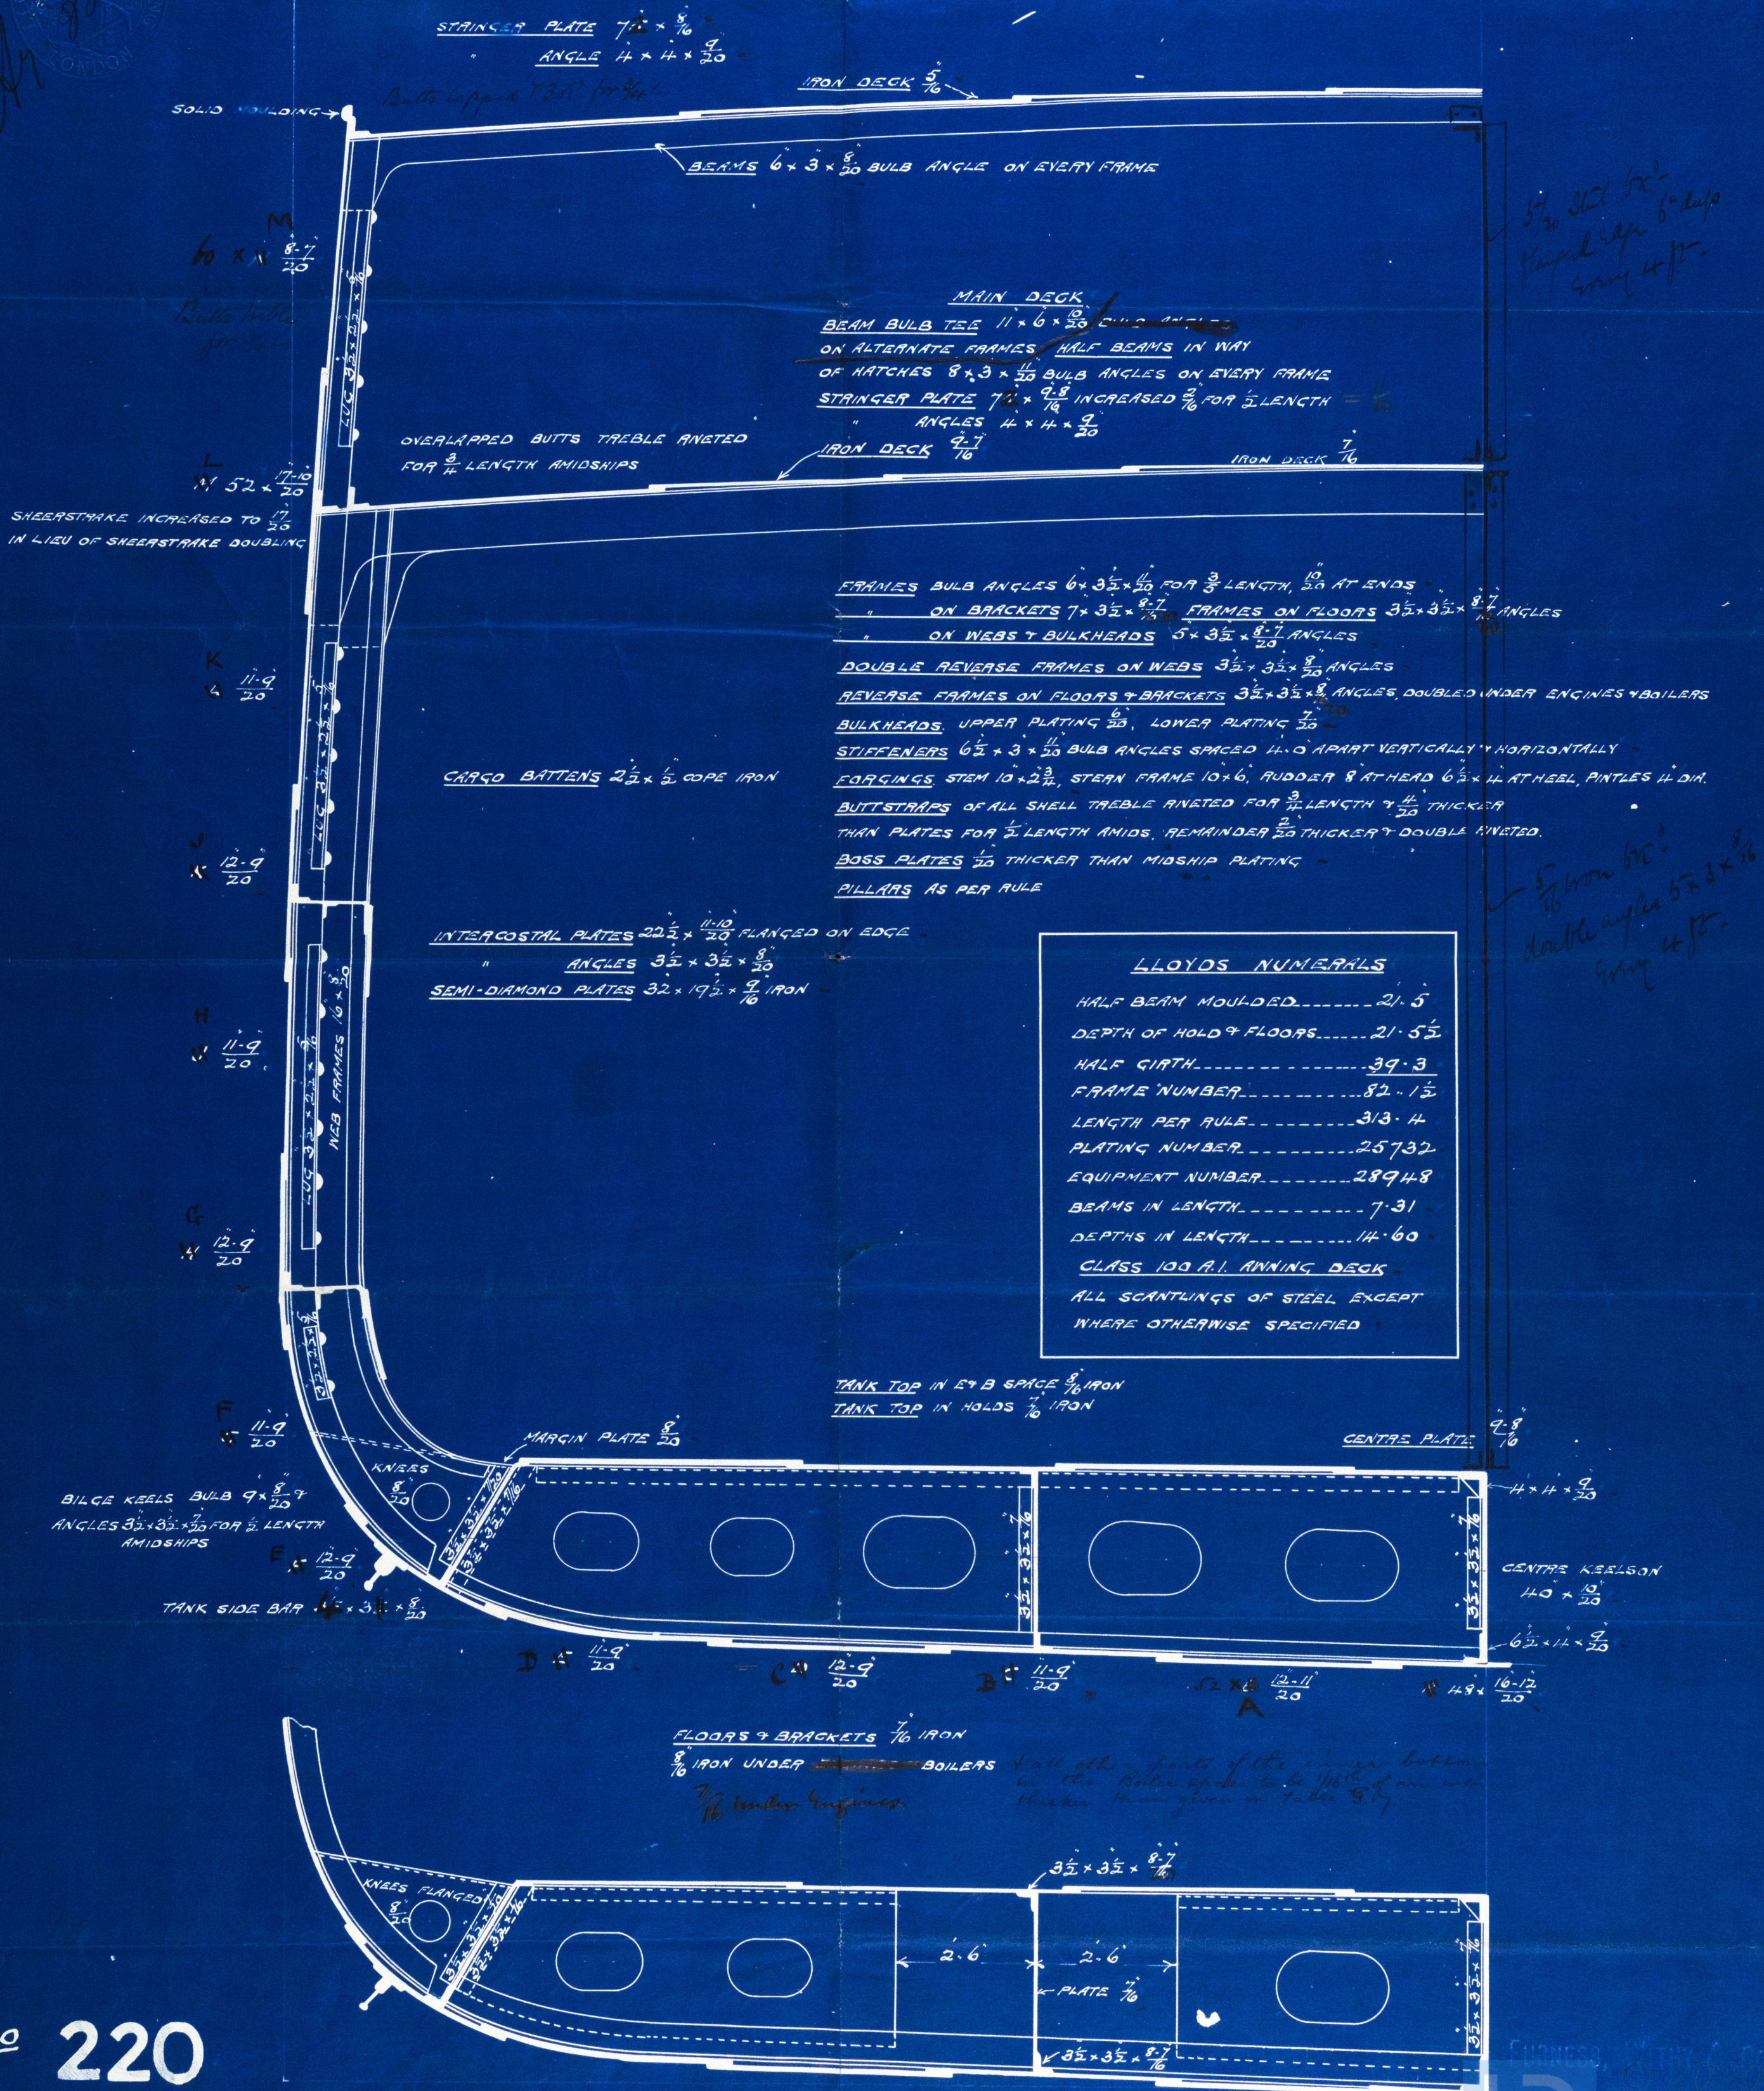


N^o 220

14/1/95
29/8/95

 492776-0224

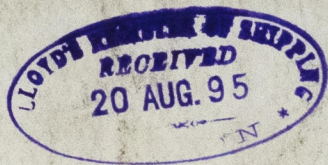

No 220
amended
midship
section

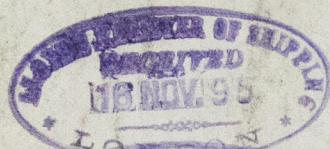

Furness Withy & Co.



S.S. 'Grantor',
W. Withy Report No. 9846
No. 1st entry No. 9869.

HPL376-0224



© 2020

Lloyd's Register
Foundation