
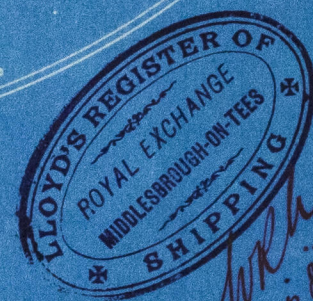
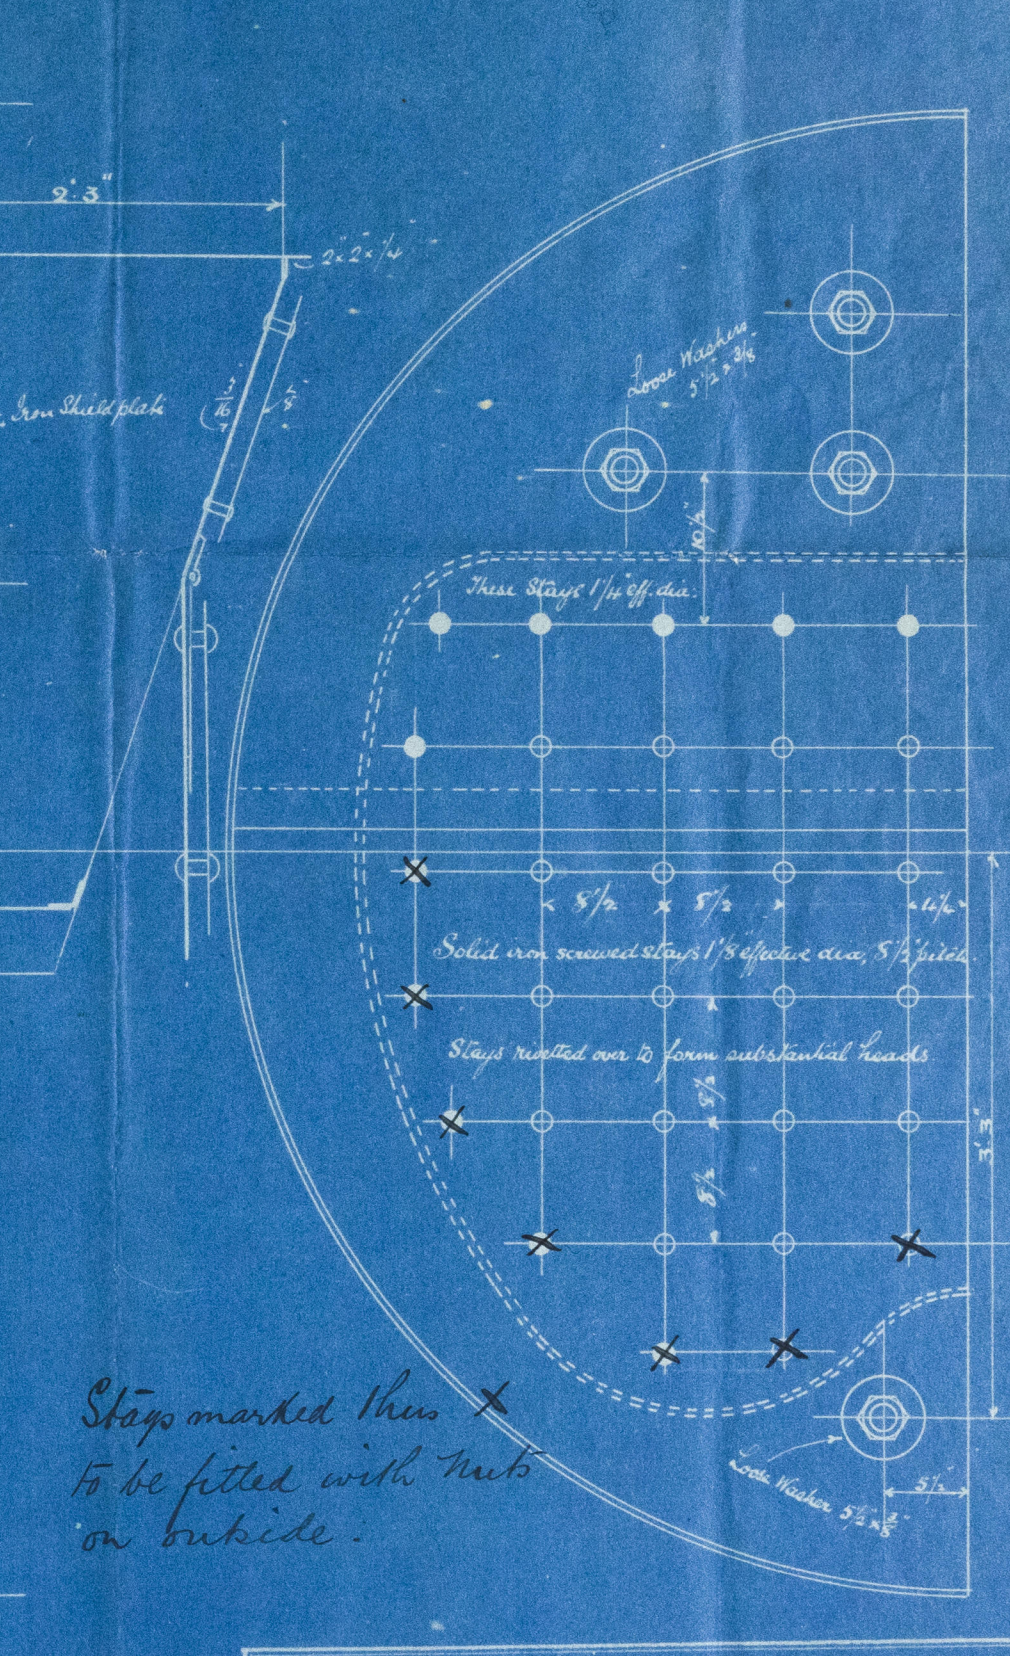
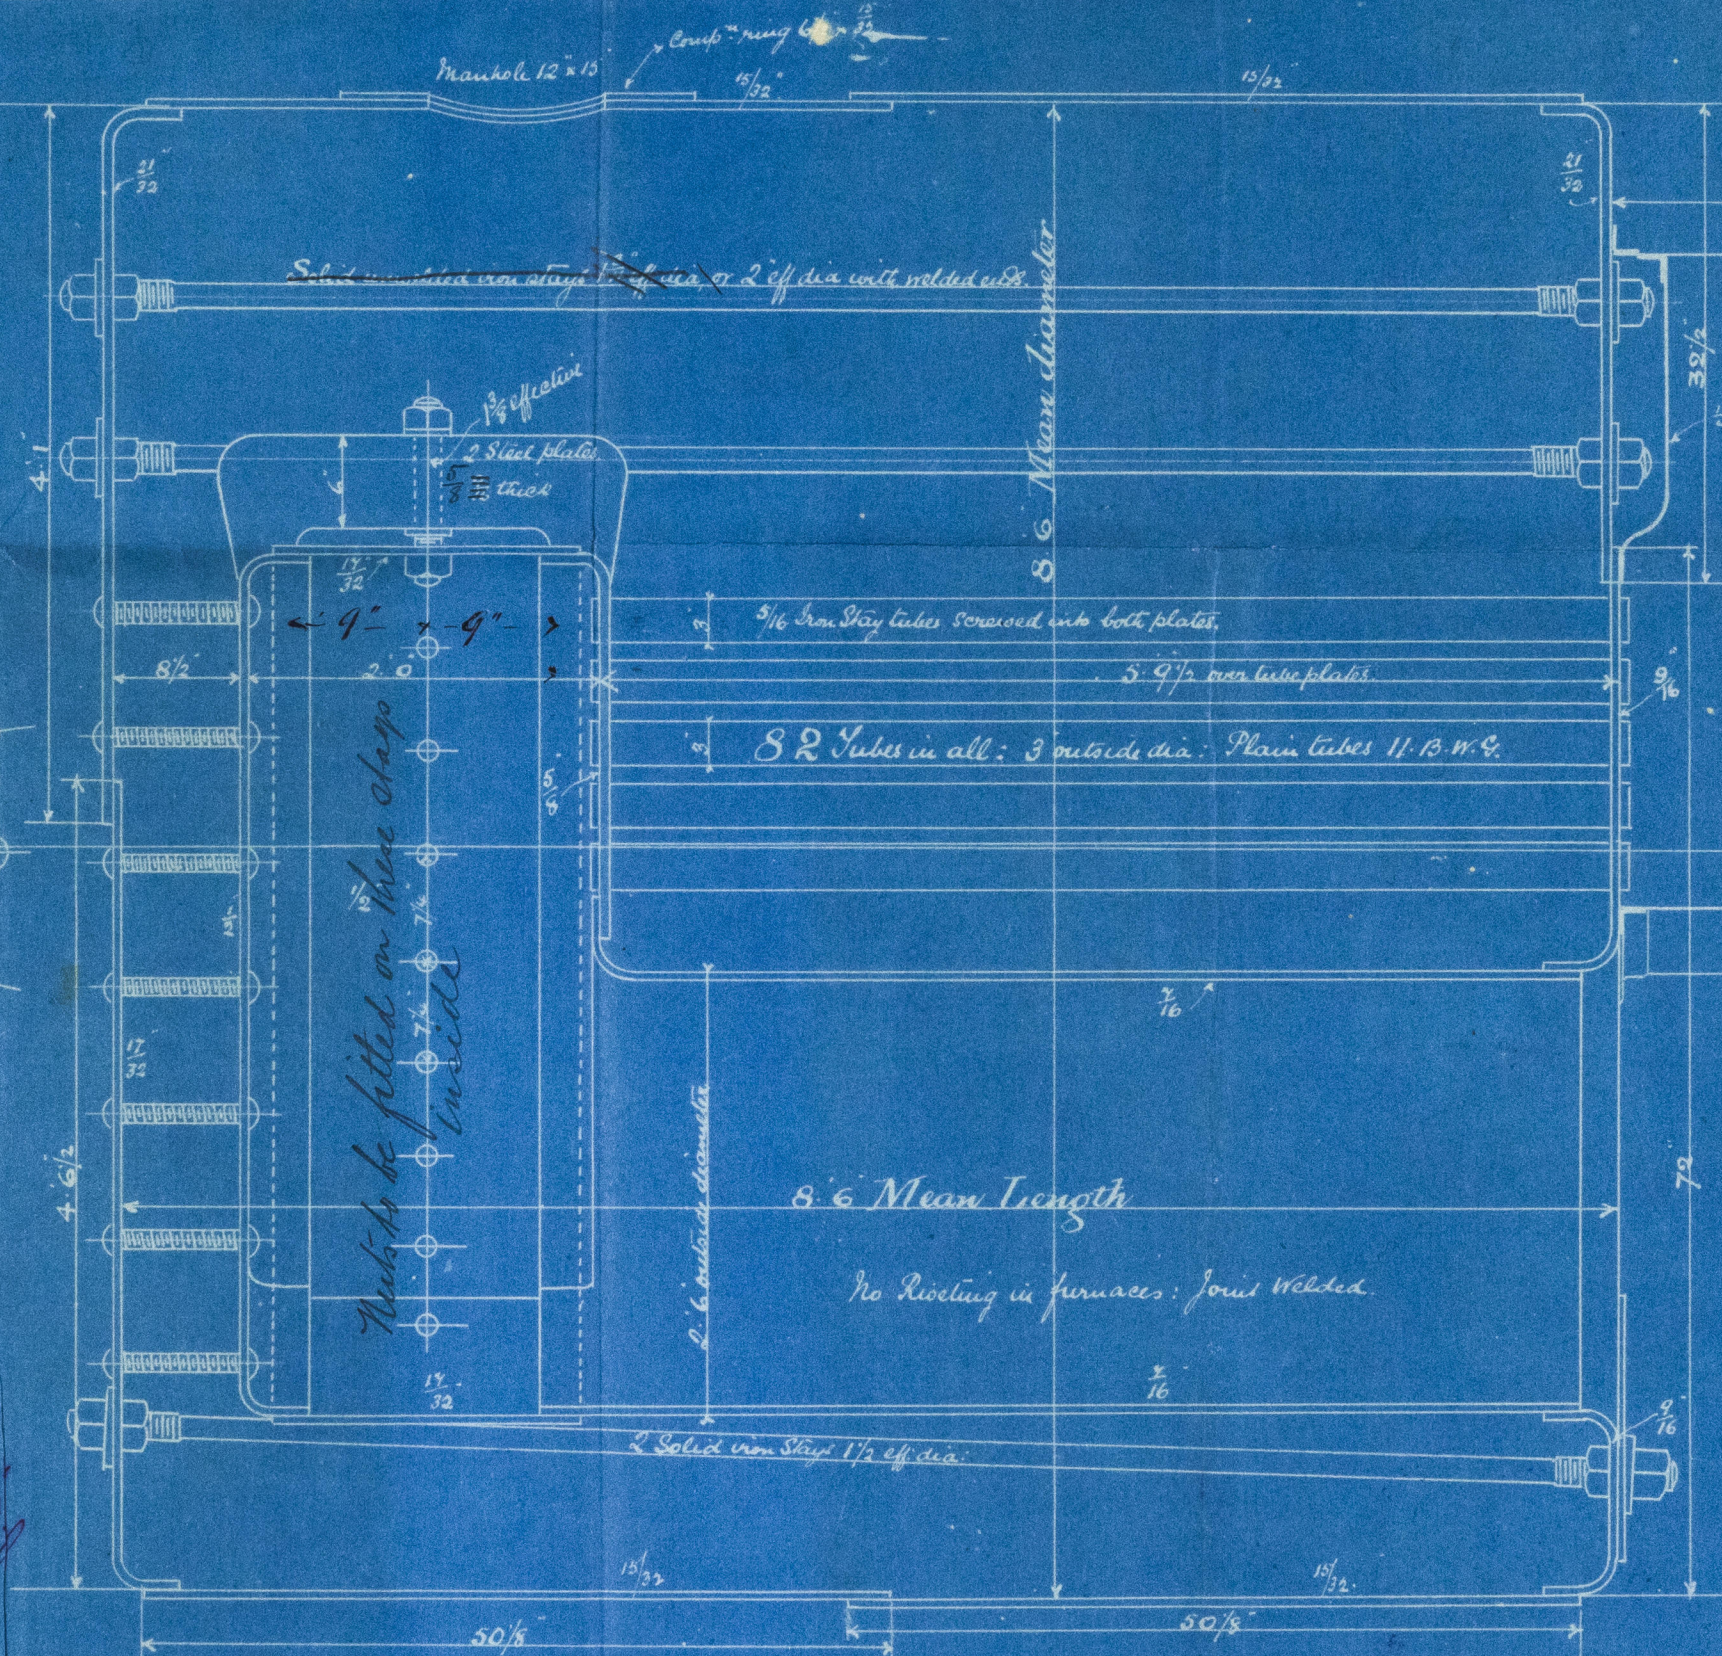


STEEL BOILER

SCALE 1" = 1 FOOT

FOR MESS^{RS} FURNESS WITHY, & CO^S N^o 220
 WORKING PRESSURE 80 LBS^{sq} (Lloyds)
 ORDER N^o 920.

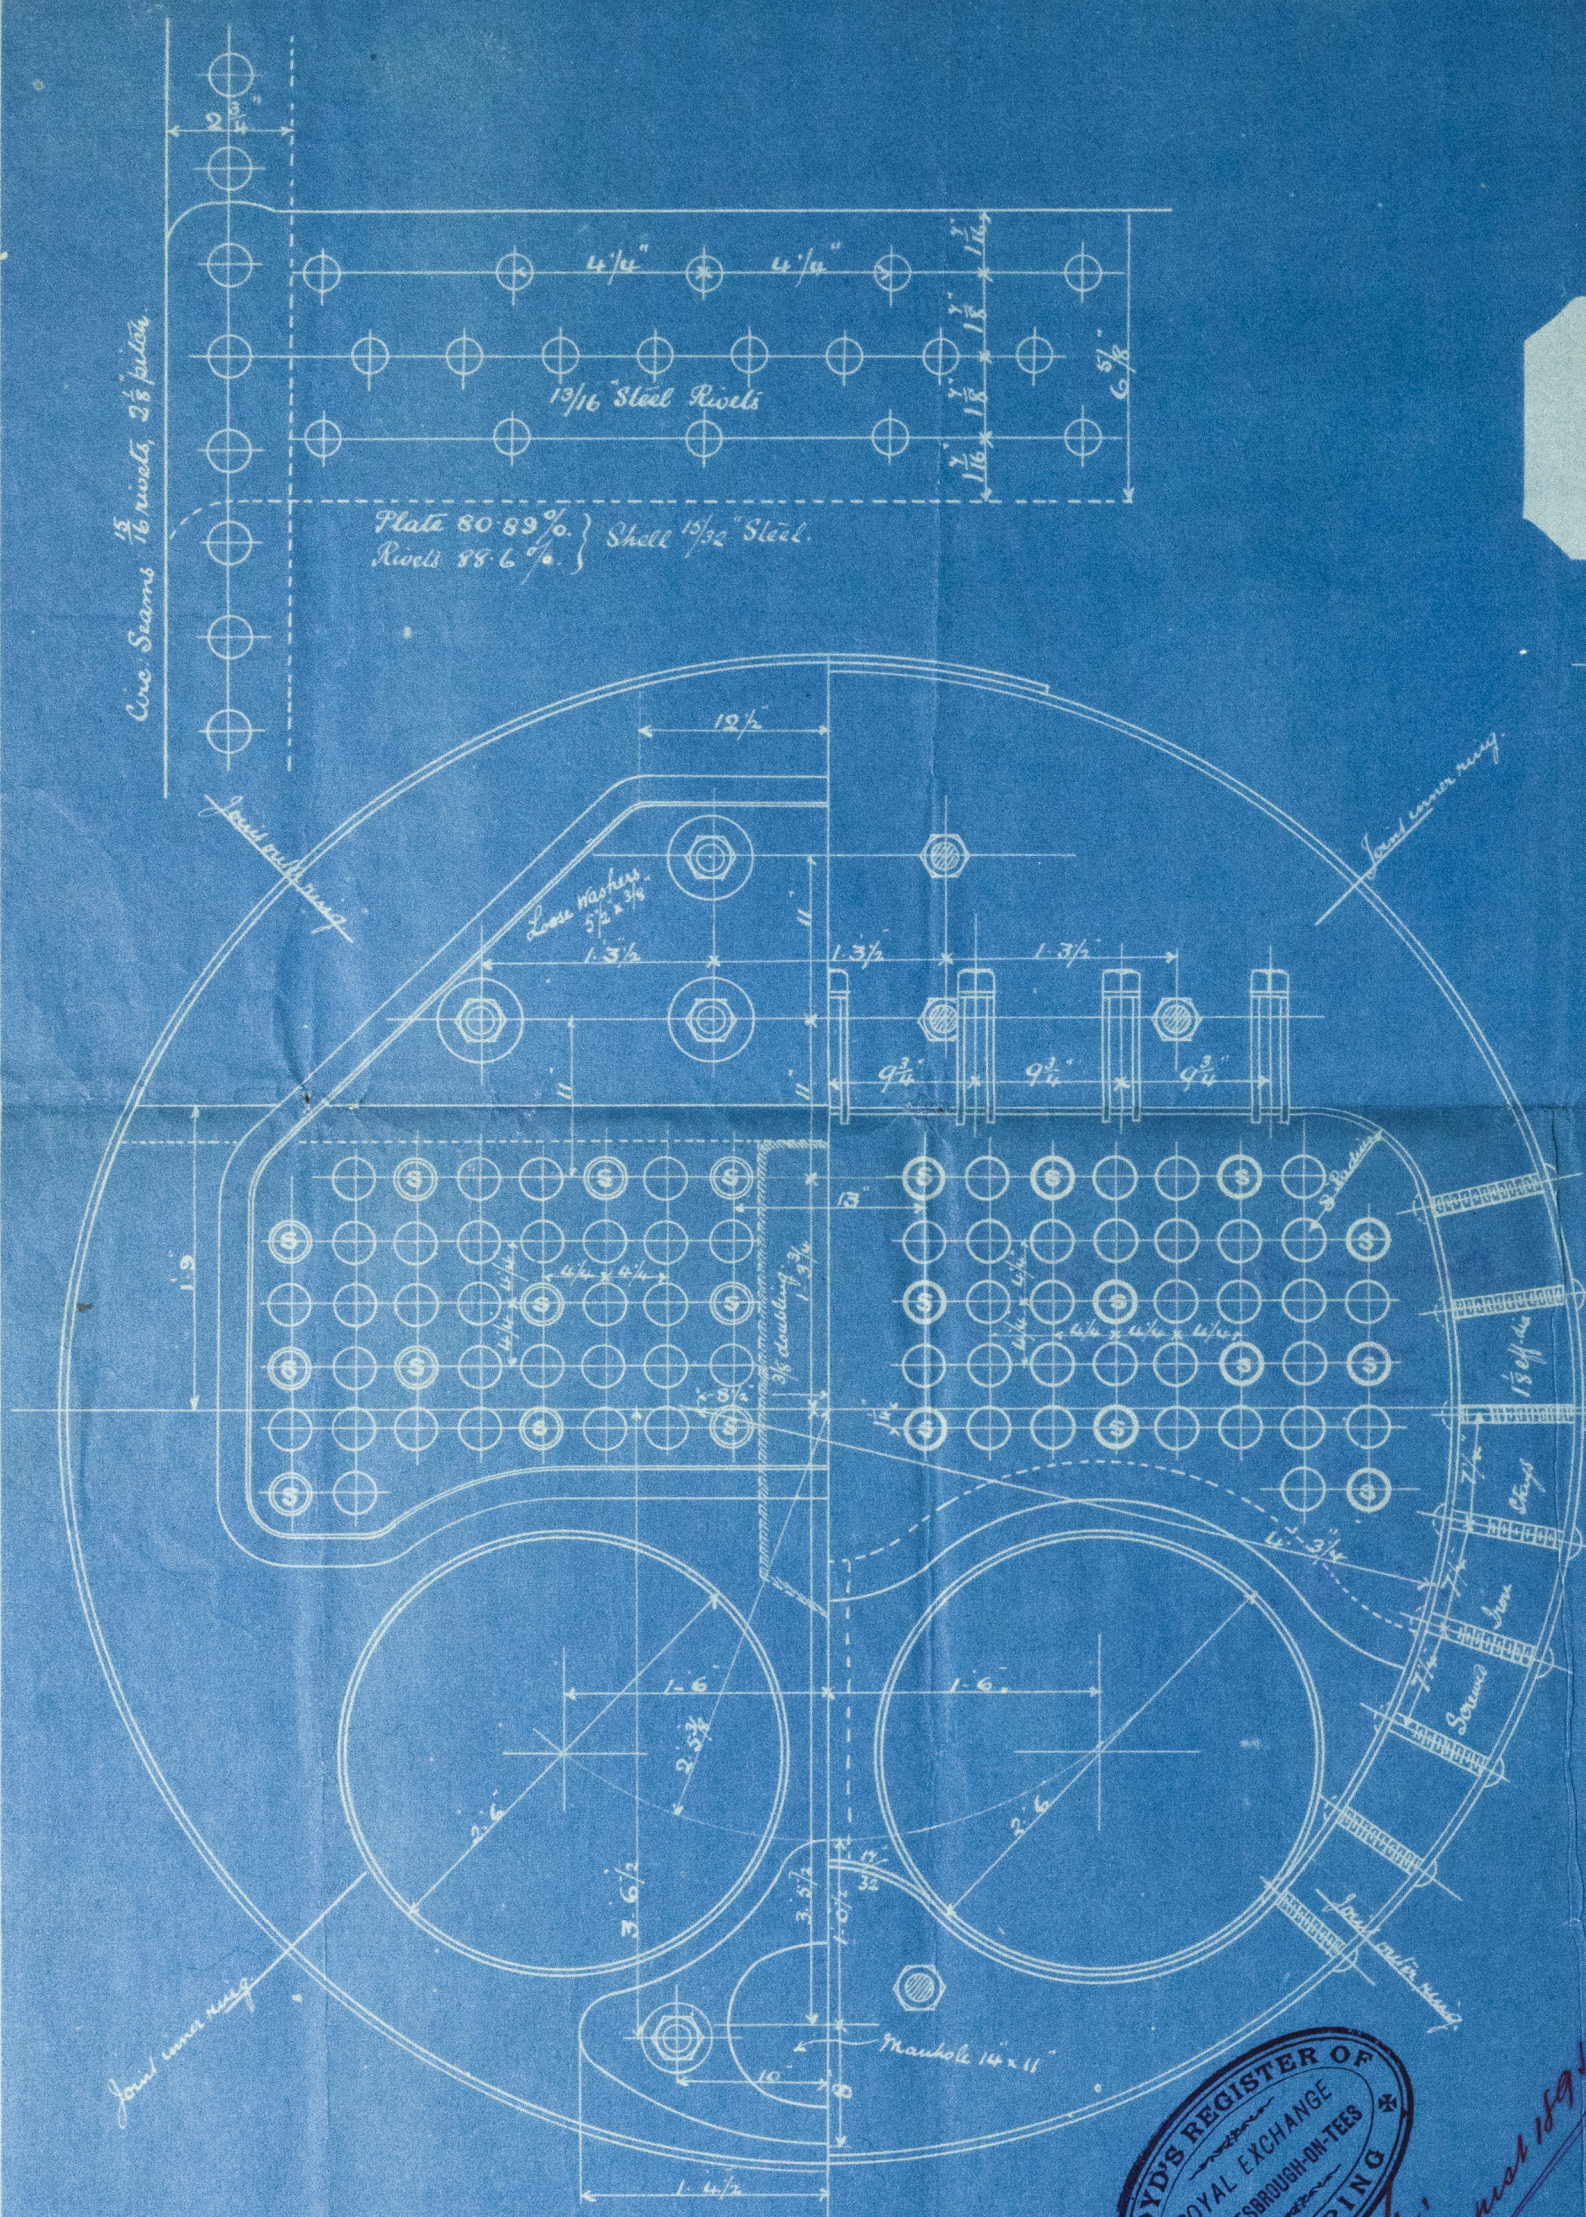

W.H. 28 August 1891

*Stays marked thus X
 to be fitted with nuts
 on outside.*

THOS SUDRON & CO LTD
 IMPERIAL BOILERWORKS
 STOCKTON-ON-TEES

12/7/95

Lloyd's Register
 HPL376-0225

Furness Mithy 1873

No 220 vessel


sp. "Grantor"

Intro report No 1644

W. Hpl. Report No 9869

HPL376 - 0225




© 2020

Lloyd's Register
Foundation