

Superheating Main  
Boiler steam.

H. Gray & Co.  
No 512 Vessel

N.P. 255 lbs

S.S. "Inchmuna"  
W. H. Pl. Report No 9960

HPL 377-0156



Scale 1" = 1' 6"

Inchmuna  
No 512




© 2020

Lloyd's Register  
Foundation




14.12.95

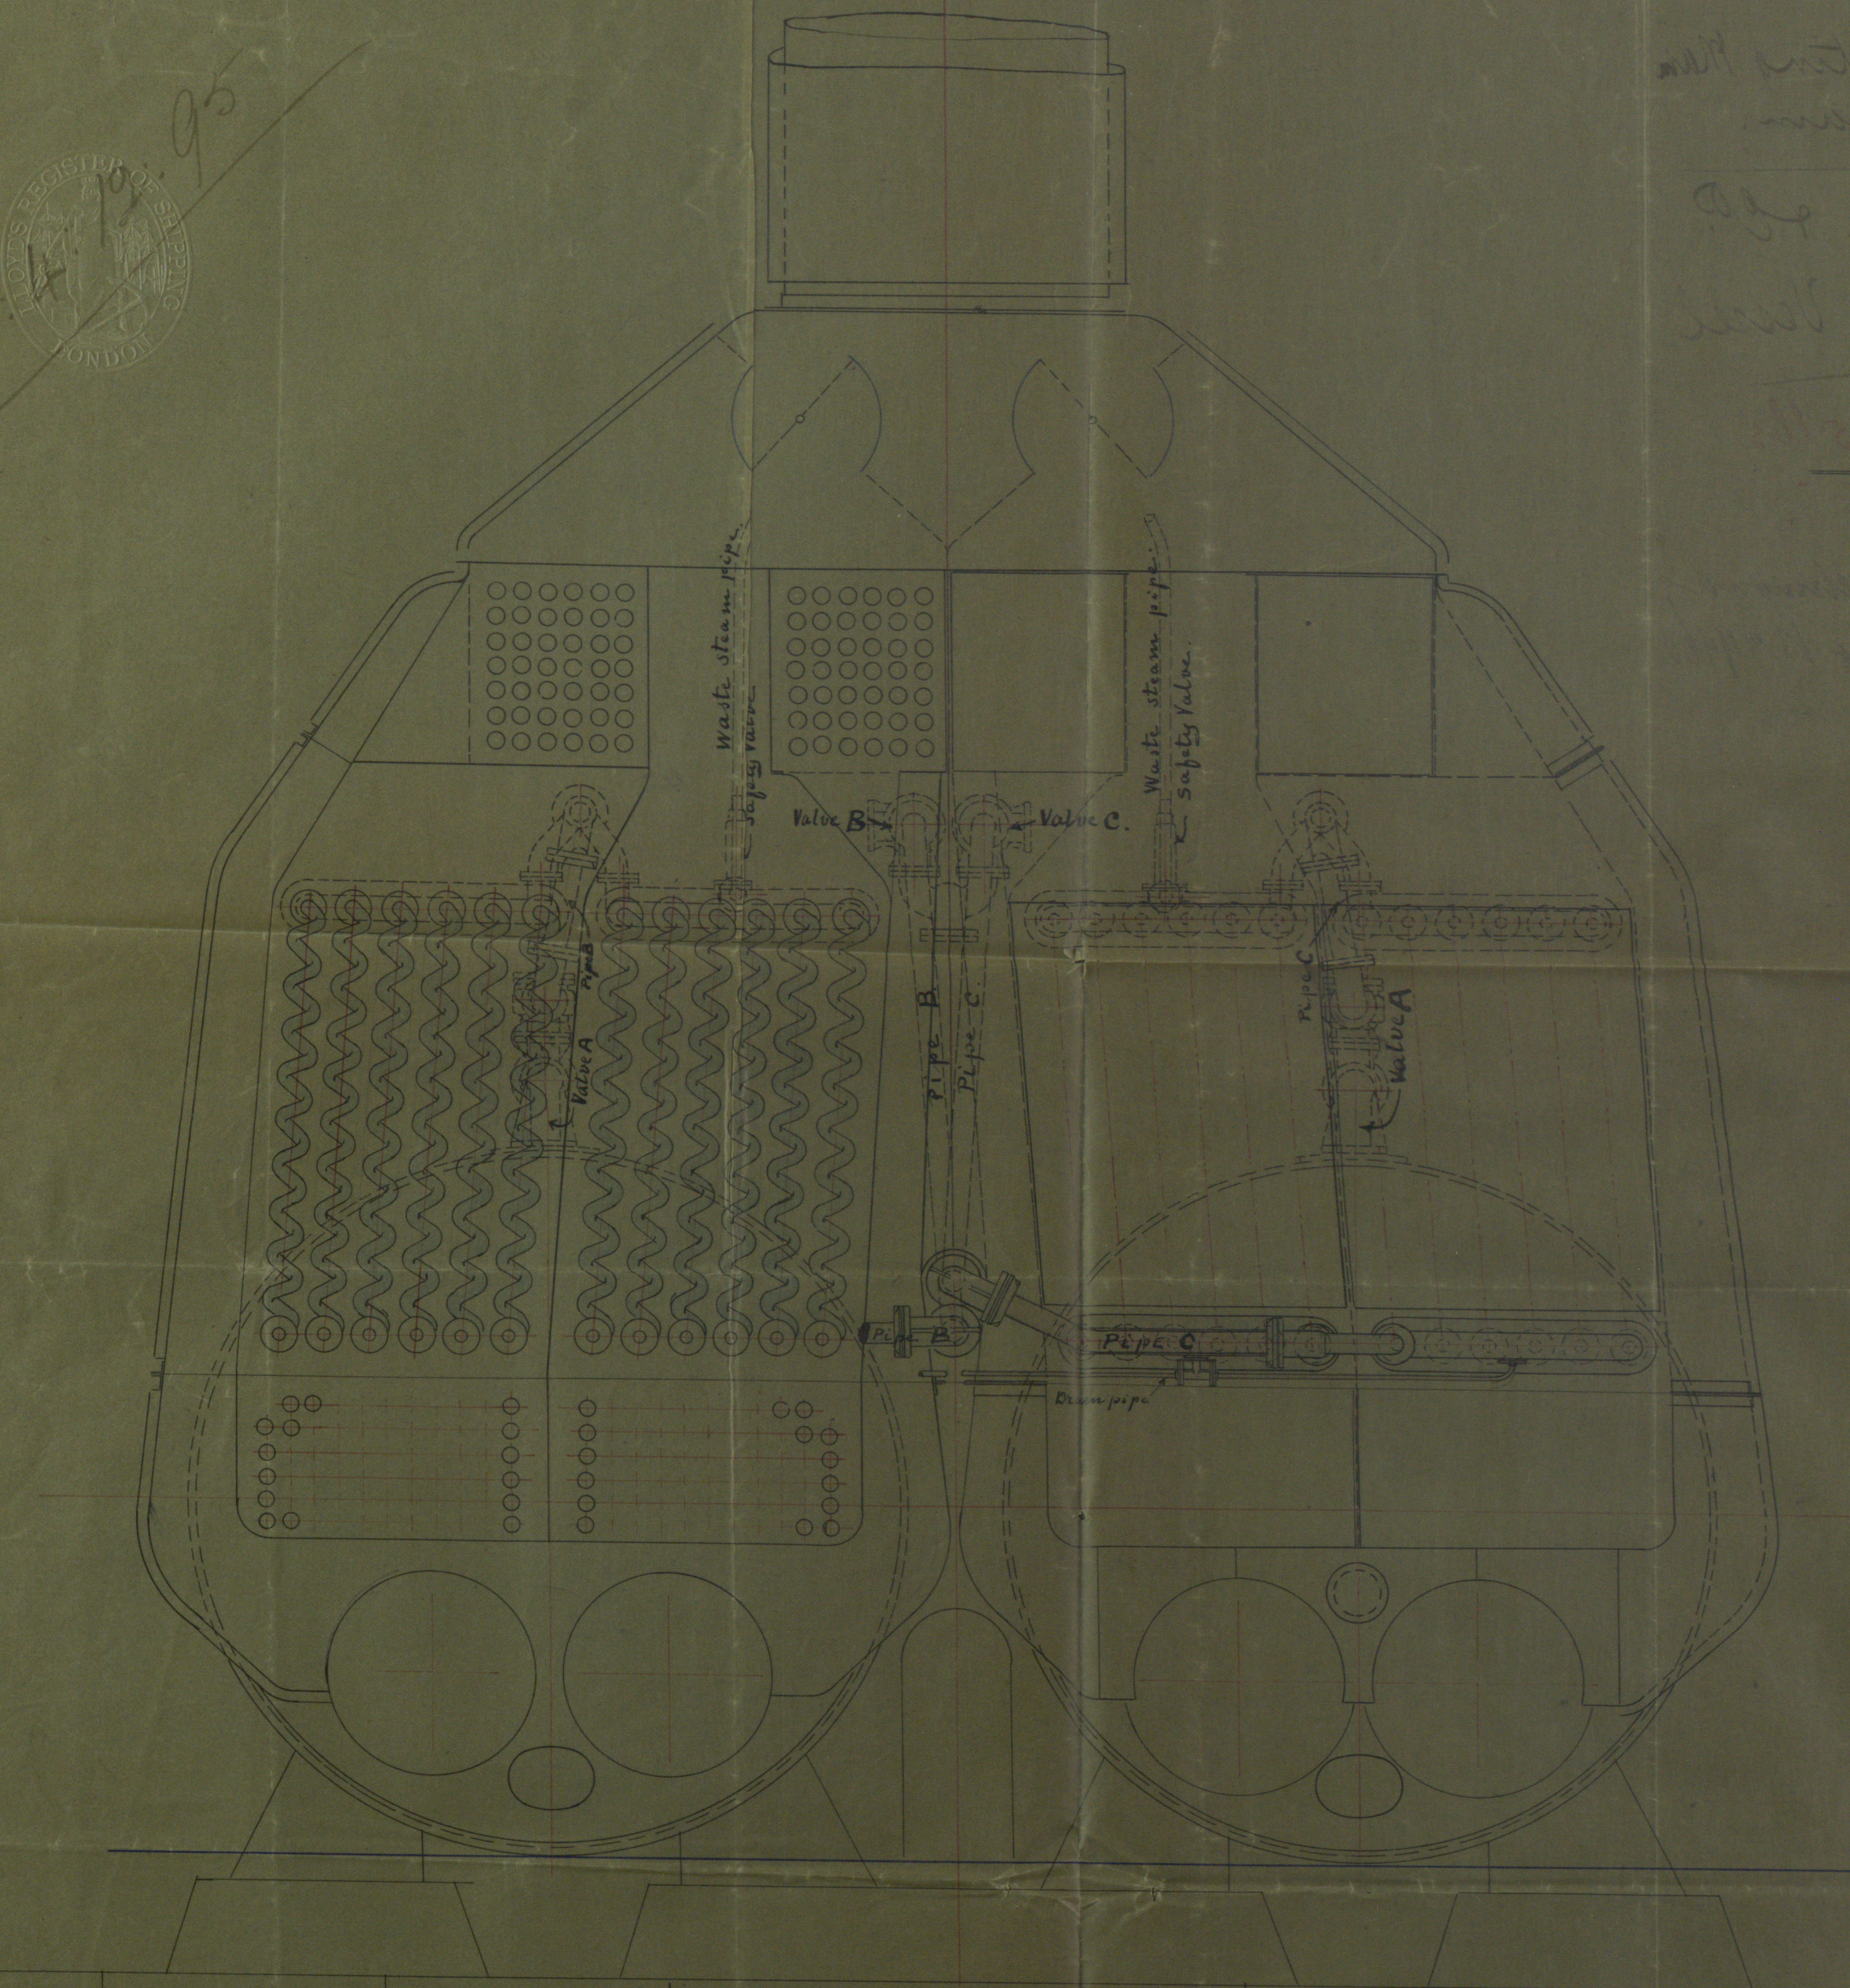

Steam arrangements  
Boilers No 512

Scale  $\frac{1}{2}$ " = 1 Foot

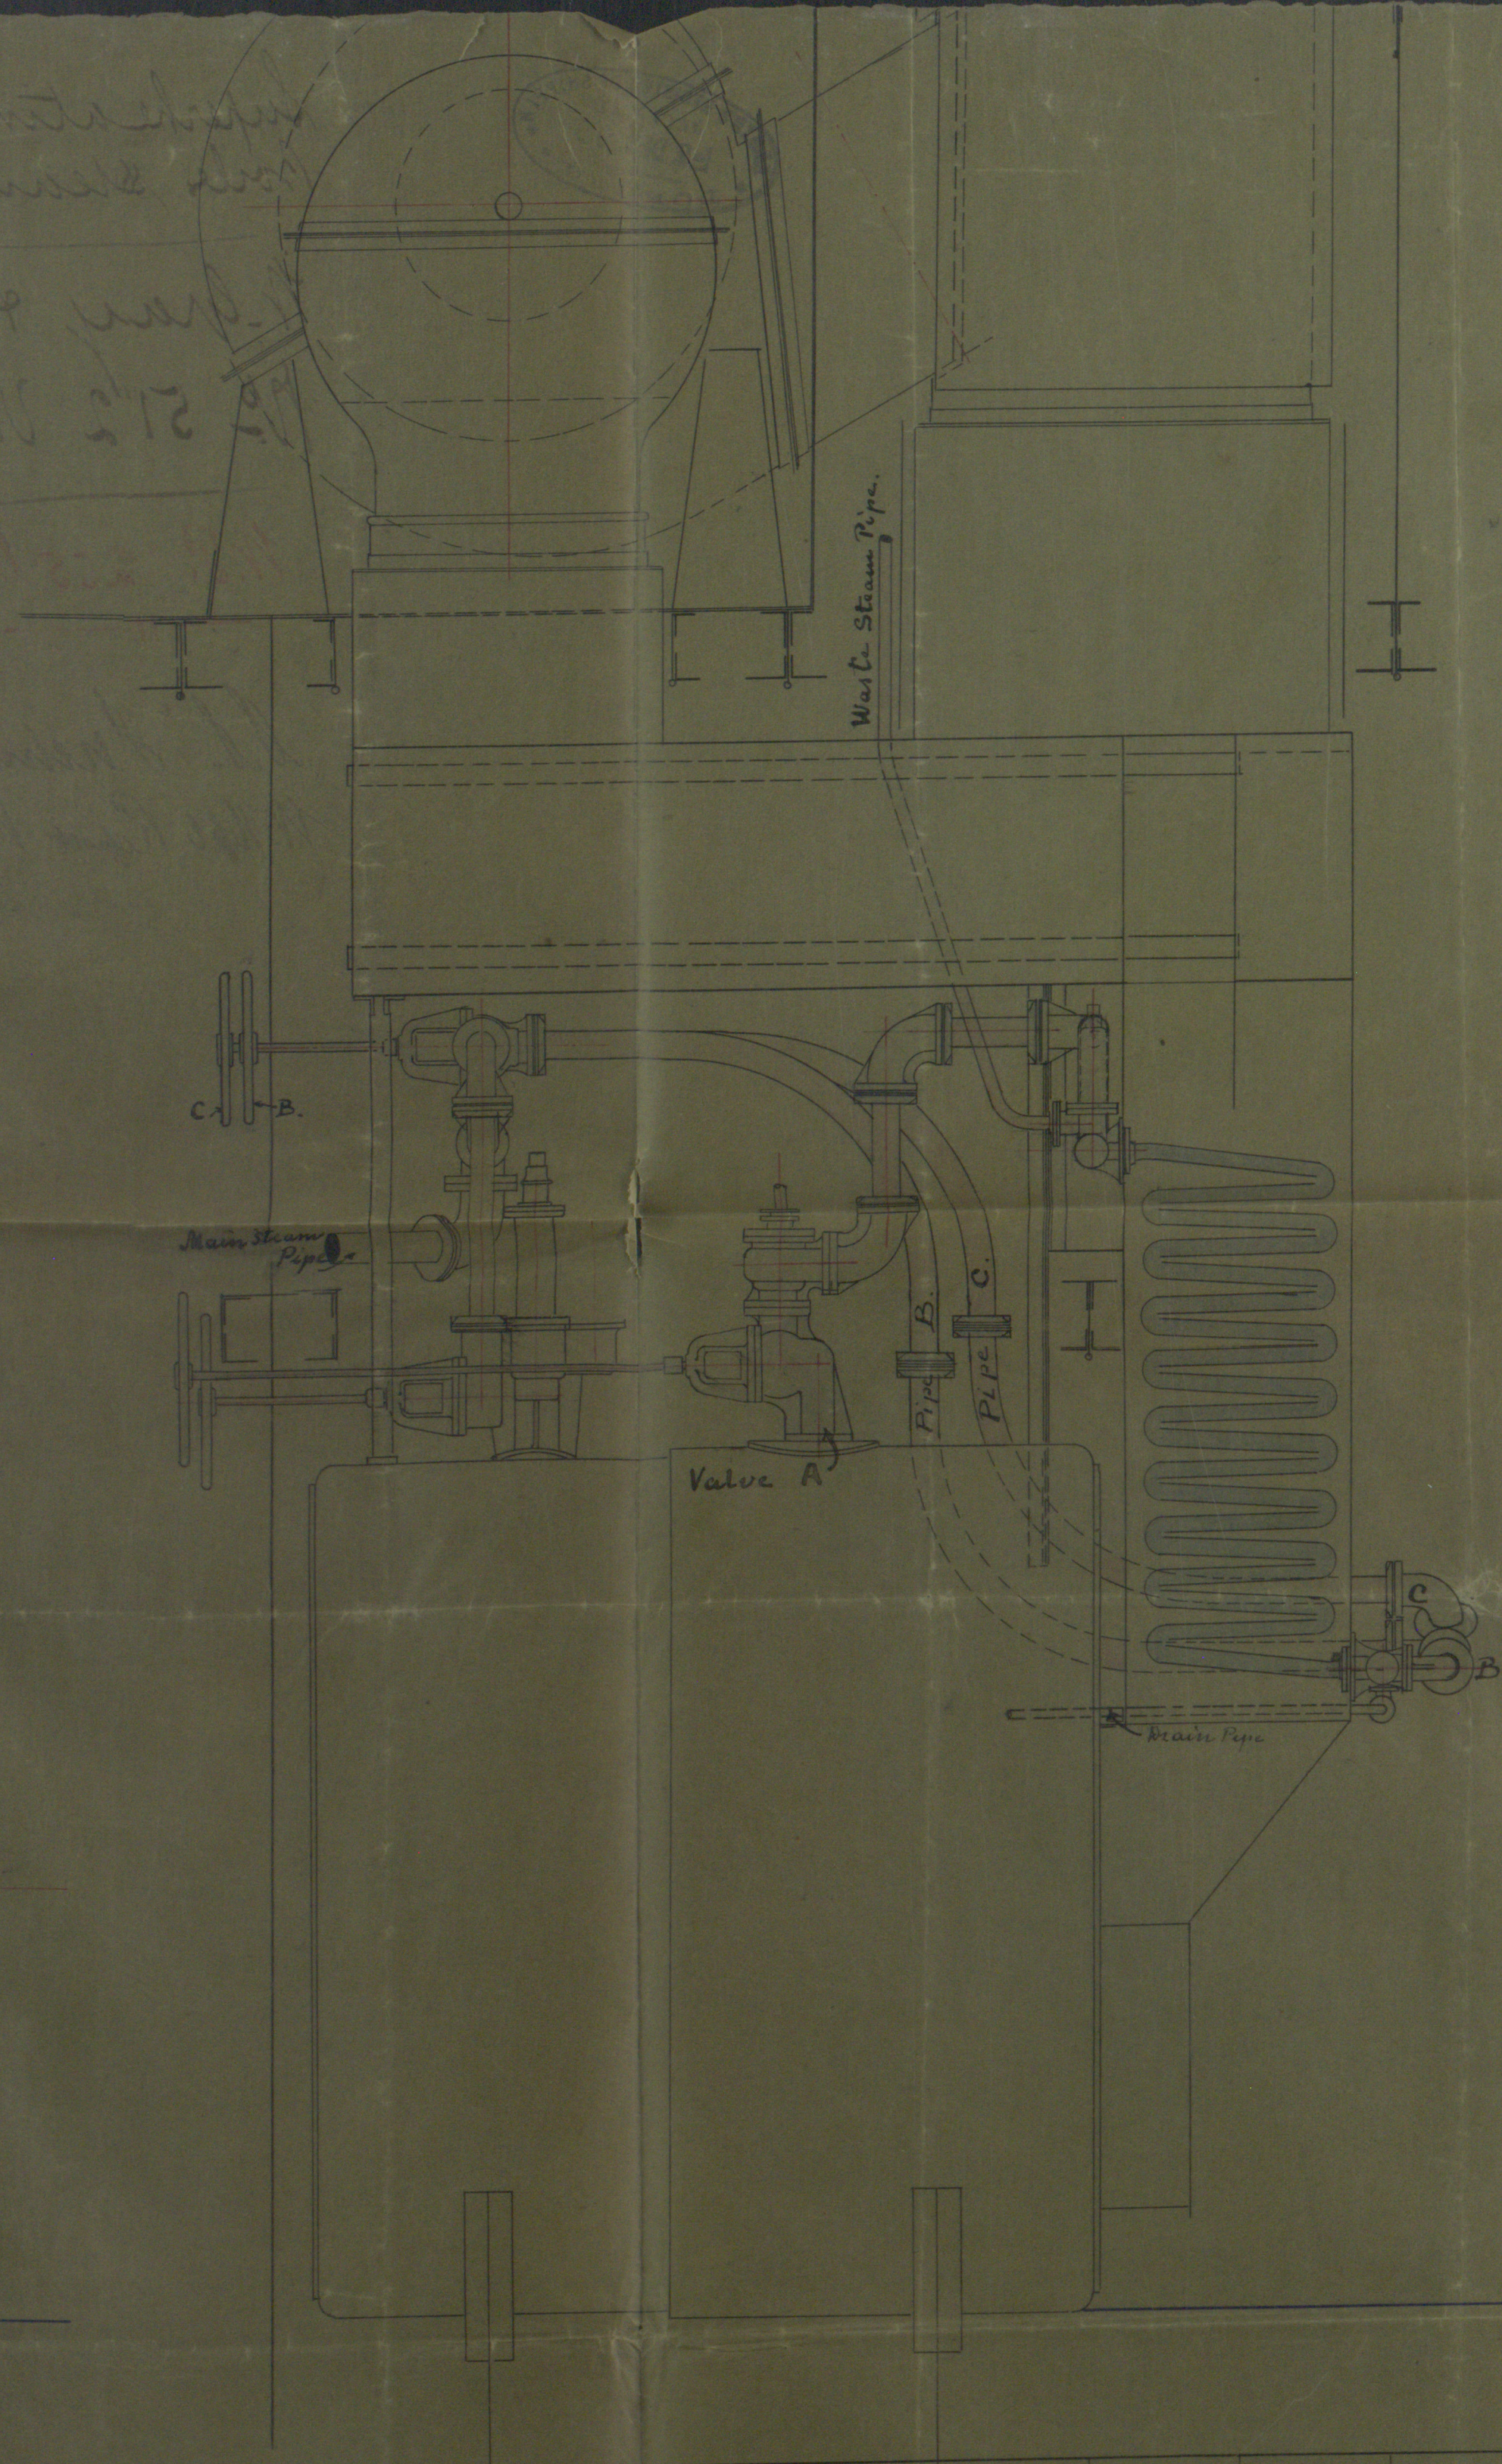

CENTRAL WATER  
ENGINEERING  
25 NOV 1905  
12433

MS 20/11/95

J.M.  
4/12/95