

S.S. Inchmuna

Received at WEST HARTLEPOOL office.

8. 4. 1896.

Lloyd's Register of British and Foreign Shipping.

Wpool (Report on Vessel No. 9960 Port WEST HARTLEPOOL.)

No. 3142 a SHIP FORGINGS OR CASTINGS.

I have to report that the undermentioned Iron ~~or Steel~~ Forgings ~~or Castings~~,
manufactured by *Messrs H Gray Co.*
of *Worthpoole* for the Vessel No. *512*, being built
by *Messrs H Gray Co.* of *Worthpoole*
have been inspected by me as set forth below, and found to be, so far as can be seen,
sound.

The words FORGINGS or CASTINGS, IRON or STEEL, should be struck out as may be required.


Mark on Forgings.

Lloyd's
No. 3142 a
No. 6

Worthpoole
Sunderland
24. 4. 96

	STERN FRAME.	RUDDER FRAME.	STEM.
Material*	<i>Scrap iron</i>	<i>scrap iron</i>	<i>scrap iron</i>
How made	<i>Forged</i>	<i>Forged</i>	<i>Forged</i>
Dimensions	<i>10' x 6'</i>	<i>8 1/2' - 4 3/4'</i>	<i>10' x 2 3/4'</i>
Progress on Inspection	<i>Forged & smoothed</i>	<i>Forged & smoothed</i>	<i>Forged</i>
Date when Inspected	<i>Sept 25th to Nov 28/95</i>	<i>Jan 2nd to March 3/96</i>	<i>Nov 2/95</i>

SKETCHES OF FRAMES SHOWING POSITION AND DESCRIPTION OF WELDS OF FORGINGS, OR PARTICULARS OF TESTS APPLIED TO CASTINGS.

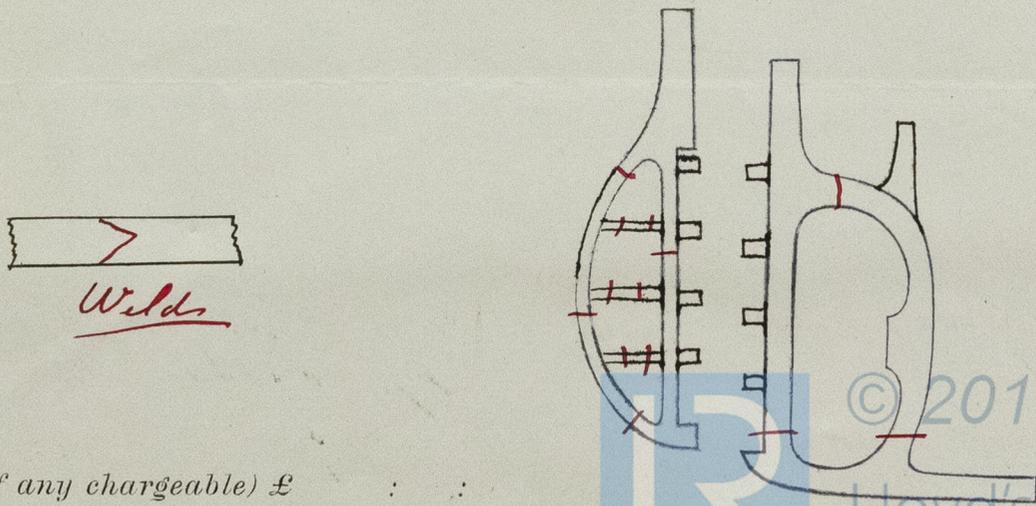

Fee (if any chargeable) £ : :

To be paid at

* If of Iron, state whether scrap or puddled Iron.

