

*W Gray & Co. 58 512*  
*Pumping Plan*



*S.S. 'Inchmuna'*  
*W. Hpl. Report No. 9960*

HPL377-0200



© 2020


Lloyd's Register  
Foundation




# S.S. N<sup>o</sup> 512. PUMPING ARRANGEMENT

SCALE  $\frac{1}{8}$  INCH = 1 FOOT.

Under deck tonnage about 3200 tons.

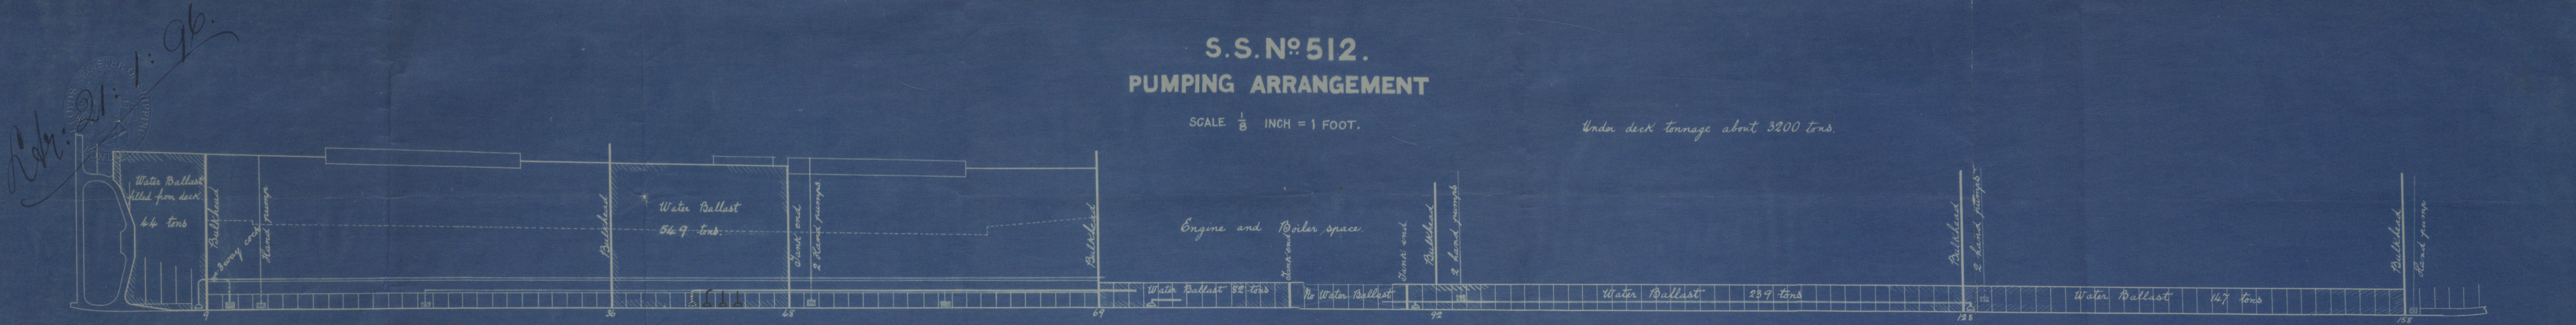

All hand pumps worked from deck

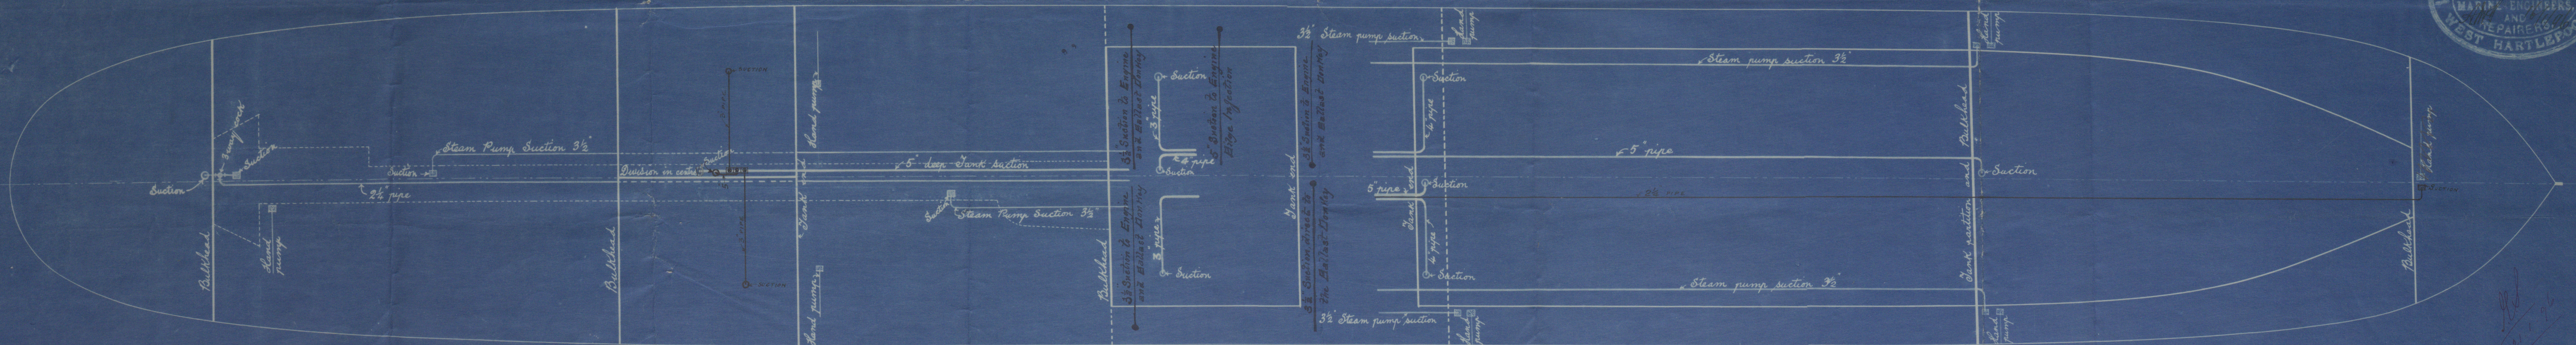

See & surrounding pipes to be fitted.

