



W Gray & Co Lms
CS 672

Deep Tank bKas

S.S. 'Inchmona',
W. H. Report No. 9960

HPL377-0201




© 2020

Lloyd's Register
Foundation





S.S. No 512.


SKETCH SHOWING STIFFENING OF DEEP WATER BALLAST
TANK BULKHEADS Nos 36 + 48. SCALE $\frac{1}{4}$ INCH = 1 FT

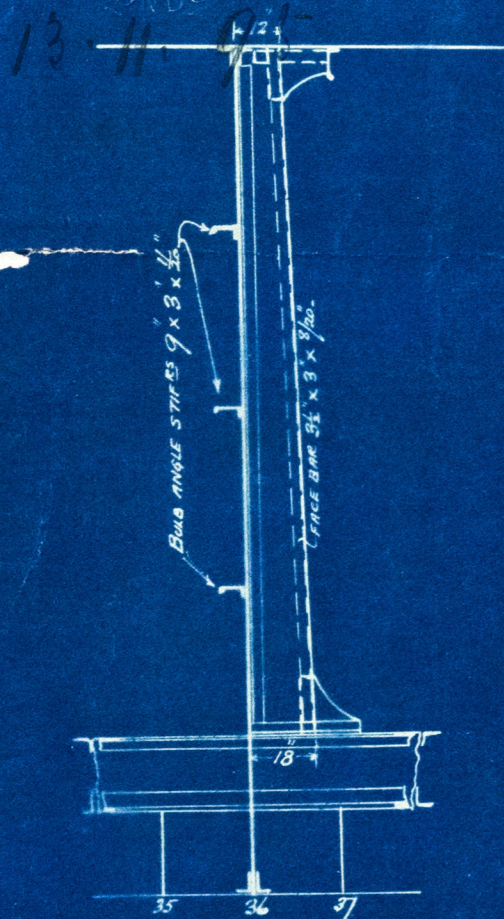

SECTION SHOWING VERTICAL WEB
STIFFERS, TWO EACH SIDE OF CENTRE LINE.

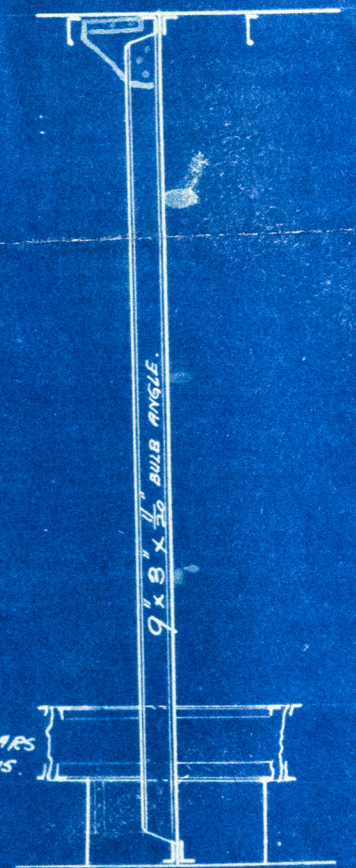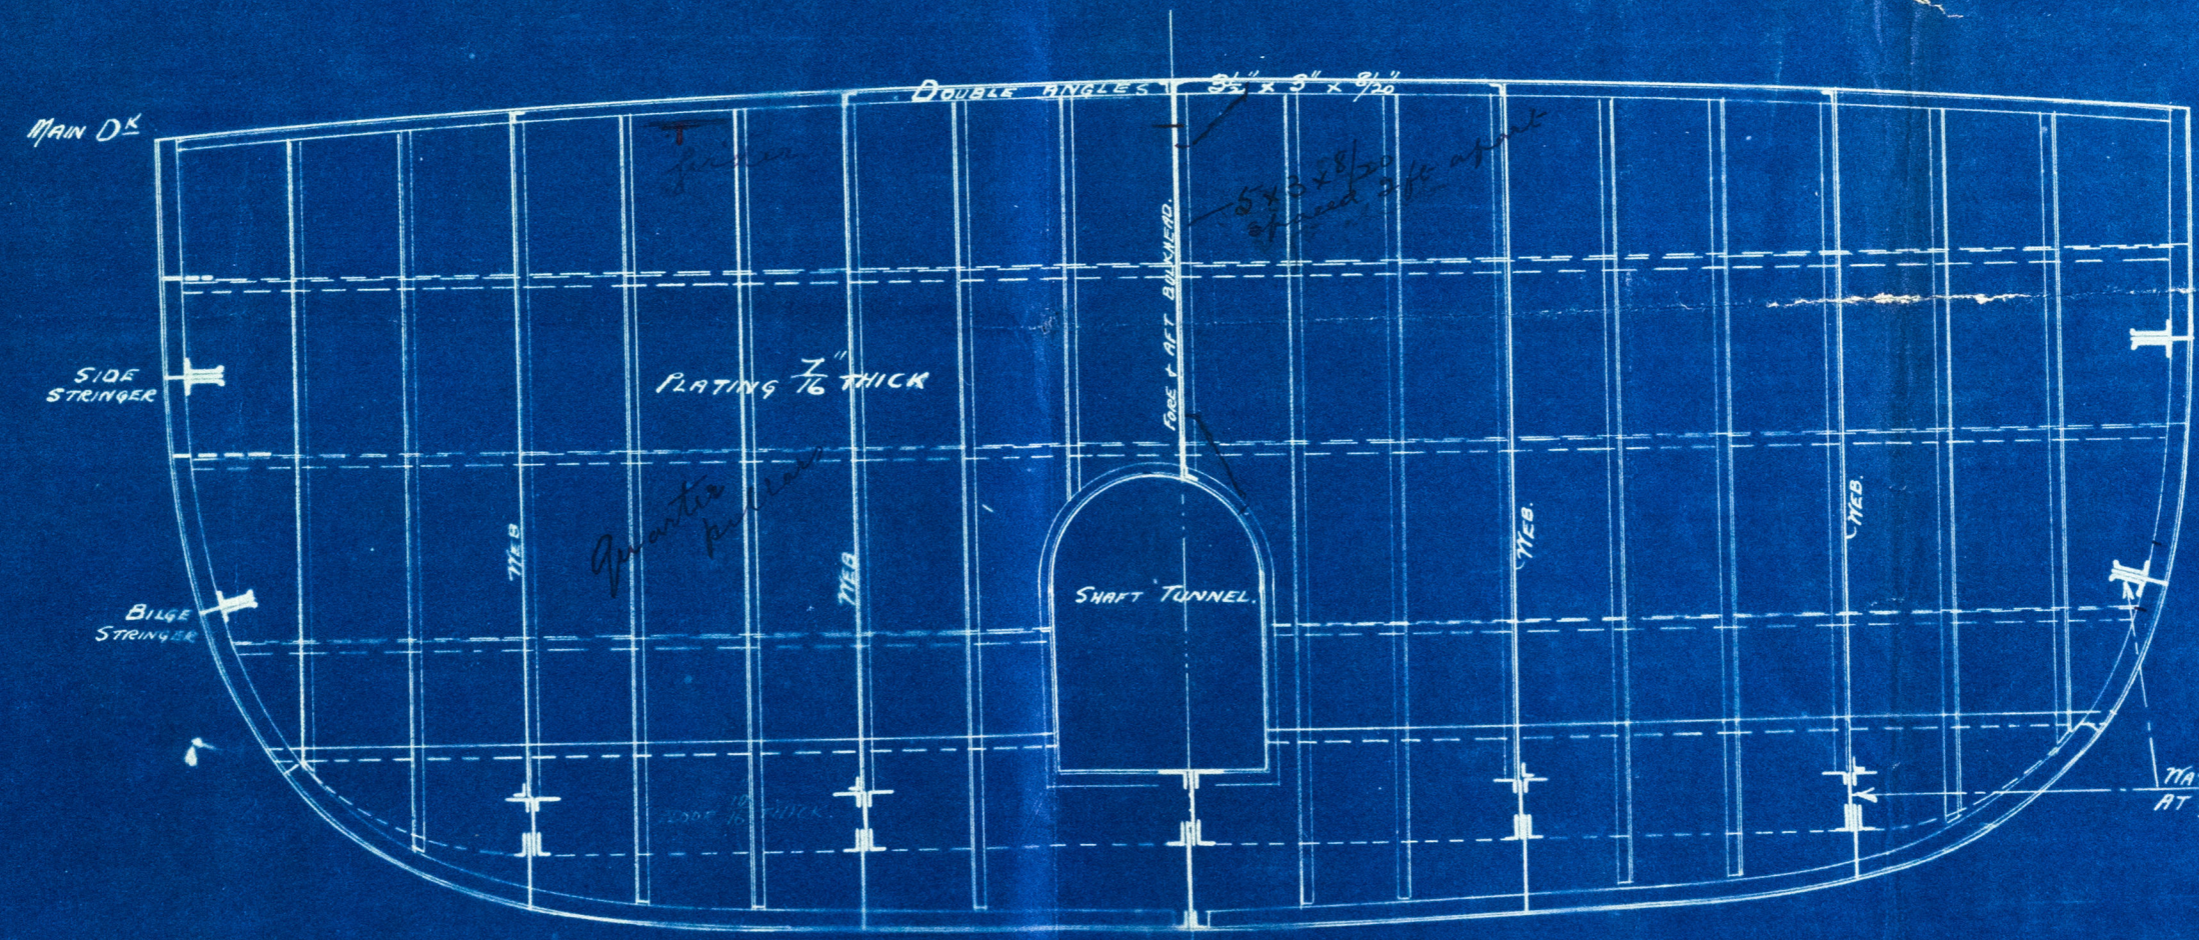

SECTION SHOWING BULB ANGLE
STIFFENER BETWEEN WEBS.

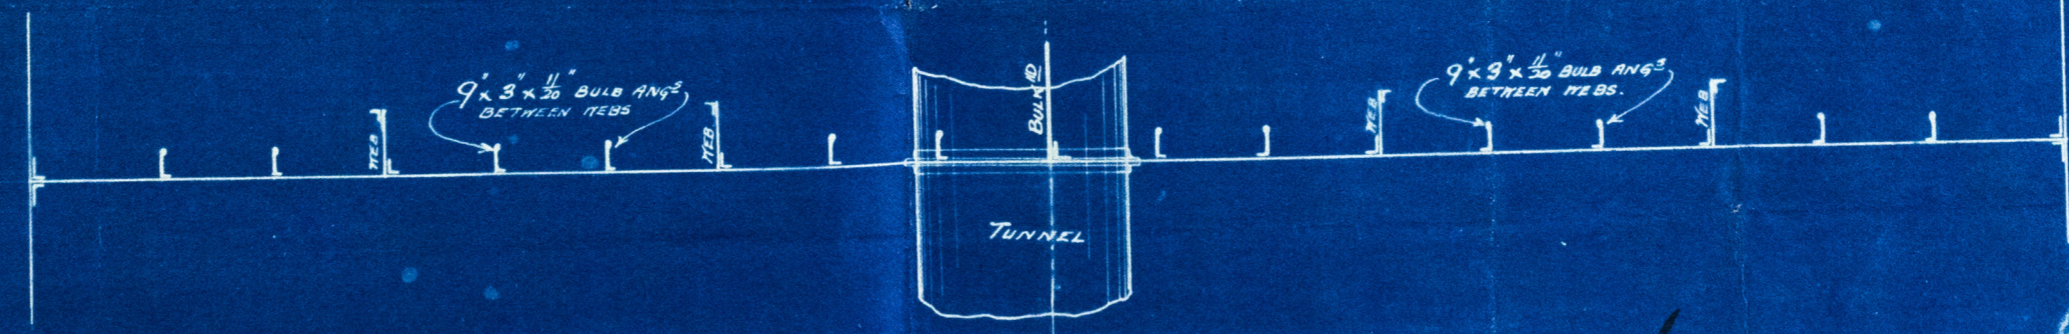

13/11/95



APL 377-0201