

Mass-Plan.
Turness Withy & Co.
No 222

S.S. 'Thomson',
W. Hpl. Report No 9962.

HPL377-0214



© 2020

Lloyd's Register
Foundation

Steel 948 Order.


SKETCH OF ~~THE~~ LOWER MASTS N^o 2225/5 (Hurness, Withy, & Co. L^d)

SCALE $\frac{1}{4}$ = 1 FOOT


Masts to be made in 2 plates in the round, outside strake on fore side, butts treble riv, seams single riveted, straps ~~to~~ ^{3/16} under than plates.
 $\frac{5}{8}$ " Rivets spaced 5" diameters

Masts to Carry fore & aft sail only

FOREMAST

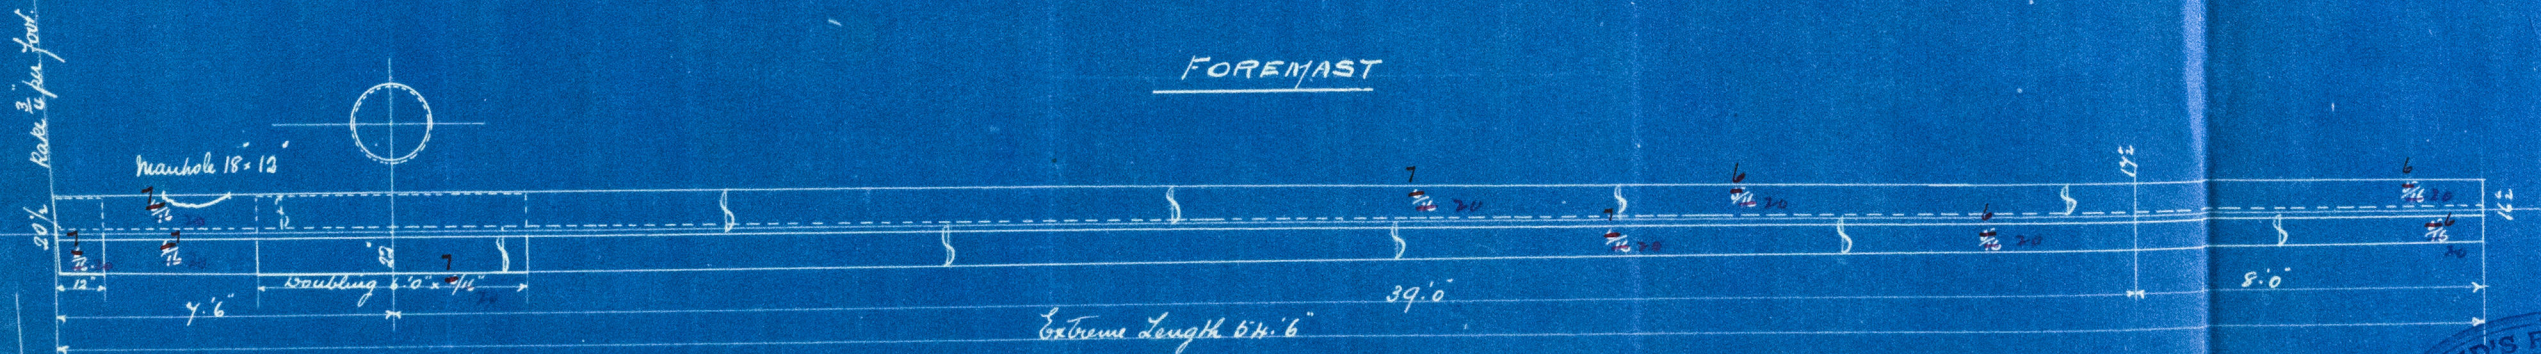

MAINMAST

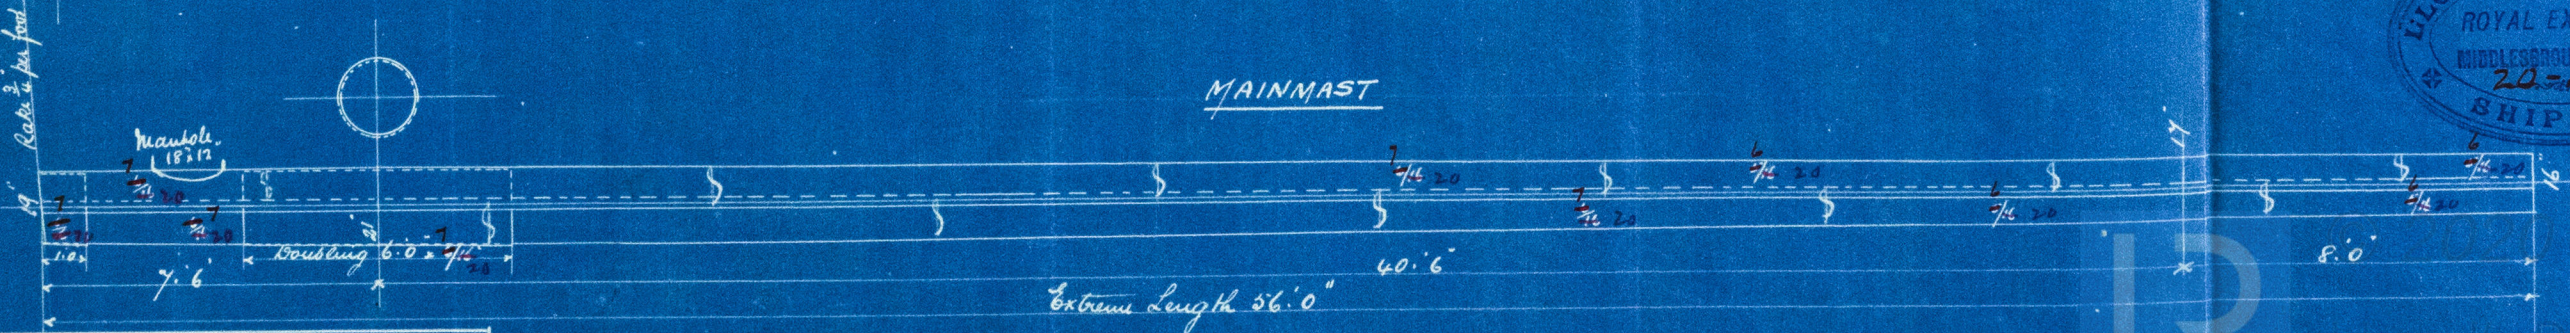

THOS SUDRON & CO. L^d
STOCKTON ON TEES



Lloyd's Register
HPL377-0216