

J.S. Munro

Received at **WEST HARTLEPOOL** Office.

16. 3. 1896

Lloyd's Register of British and Foreign Shipping.

(Report on Vessel No. 9962 Port WEST HARTLEPOOL.)

W. pool

No. 3162.a. SHIP FORGINGS OR CASTINGS.

The words FORGINGS or CASTINGS, IRON or STEEL, should be struck out as may be required.

I have to report that the undermentioned Iron ~~or Steel~~ Forgings or Castings, manufactured by *The Stockton Forge Co.* of *Stockton* for the Vessel No. 222, being built by *Super. Furness & Co.* of *Worthpool* have been inspected by me as set forth below, and found to be, so far as can be seen, sound.

Mark on Forgings.



Lloyd's
No. 3162.a.
No. 6.

Hugh Cameron
Sunderland

14. 3. 96.

	STERN FRAME.	RUDDER FRAME.	STEM.
Material*	<i>Scrap iron</i>	<i>Scrap iron</i>	<i>Scrap iron</i>
How made	<i>Forged</i>	<i>Forged</i>	<i>Forged</i>
Dimensions	<i>11 x 6"</i>	<i>9 - 1 1/4"</i>	<i>10 7/8 x 2 3/4"</i>
Progress on Inspection	<i>Forged & smithed</i>	<i>Forged & smithed</i>	<i>Forged</i>
Date when Inspected	<i>Nov 6th 23/95</i>	<i>Dec 6/95 to Feb 17/96</i>	<i>Nov 18/95</i>

SKETCHES OF FRAMES SHOWING POSITION AND DESCRIPTION OF WELDS OF FORGINGS, OR PARTICULARS OF TESTS APPLIED TO CASTINGS.

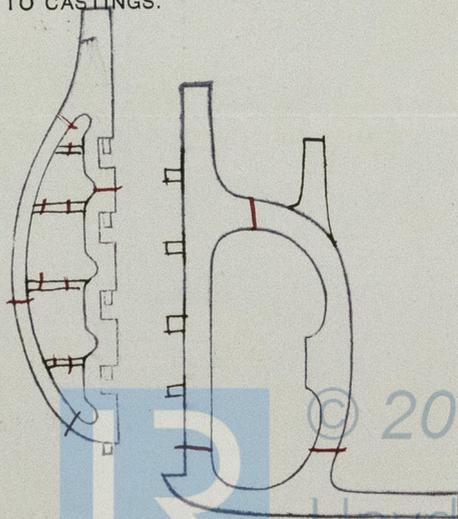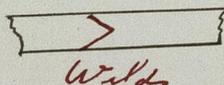

Fee (if any chargeable) £ : :

To be paid at

* If of Iron, state whether scrap or puddled Iron.